

GOVERNMENT CORNER RESTORATION FORM

Date: 10/11/95 By: BC

Township 23 Range 9W Sec. 23

County DOUGLAS

This survey consists of:

State OR

Date 10-3-95

No.

Map:

Narrative:

Corner Rpt: CS 64/64

Corner Designation

S 23 | S 24
S 26 | S 25

DOUGLAS COUNTY

- Condition Report Only
- Not Found
- Renewed
- Unrecorded
- Surveyed In
- Referenced Out

MONUMENT DETAIL

Previous Renewals #67 1973 1969

Monument(s) Found: (Condition and Source)

2" BRASS CAP ON A 1" O.D. IRON PIPE 6" BELOW GROUND (REN #67)

NO CORNER STONE FOUND

COUNTY SURVEYORS OFFICE

T 23 S R 9 W

S 23 | S 24
S 26 | S 25

1973

Accessories Found:

30" NOW 50" DIA 4 FT HIGH D.FIR STUMP WITH BARK SCRIBING VISIBLE "T23S R9W S23 BT" BEARS N24°W, 8.0 FT TO CENTER (REC N24°W 6.8 FT TO SCRIBING) OBT

20" NOW 24" DIA 1 FT HIGH ROTTED D.FIR STUMP NO SCRIBING VISIBLE BEARS N61°E, 13.5 FT TO CENTER (REC N61°E 12.7 PROBABLY DISTANCE WAS TO BARK) OBT

(BT'S NOTED IN 1973 OCSO REN #67 AS BEING FROM AN UNRECORDED RENEWAL DATED 8-13-69)

16" D.FIR NOW 25" DIA HEMLOCK WITH A FULLY HEALED DOUBLE BLAZE, BEARS N30°E, 18.9 FT (AGREES WITH REC)

30" NOW 39" DIA D.FIR WITH A FULLY HEALED DOUBLE BLAZE, BEARS S74°W, 21.3 FT. (AGREES WITH REC)

10" FUR NOW 13" DIA D.FIR DOWN AND FALLEN ON BLAZE, FOOT CROWN AGREES WELL WITH RECORD S47°E, 16.3 FT.

BE

Monument Set (Procedure and Description)

Monument Detail


NONE

N/A

New Accessories

11" DIA HEMLOCK DOUBLE BLAZED AND SCRIBED
"T235 R9W S25 CS BT" BEARS S67 1/2° E, 18° FT.

Sketch of Monument, Accessories, and General Area

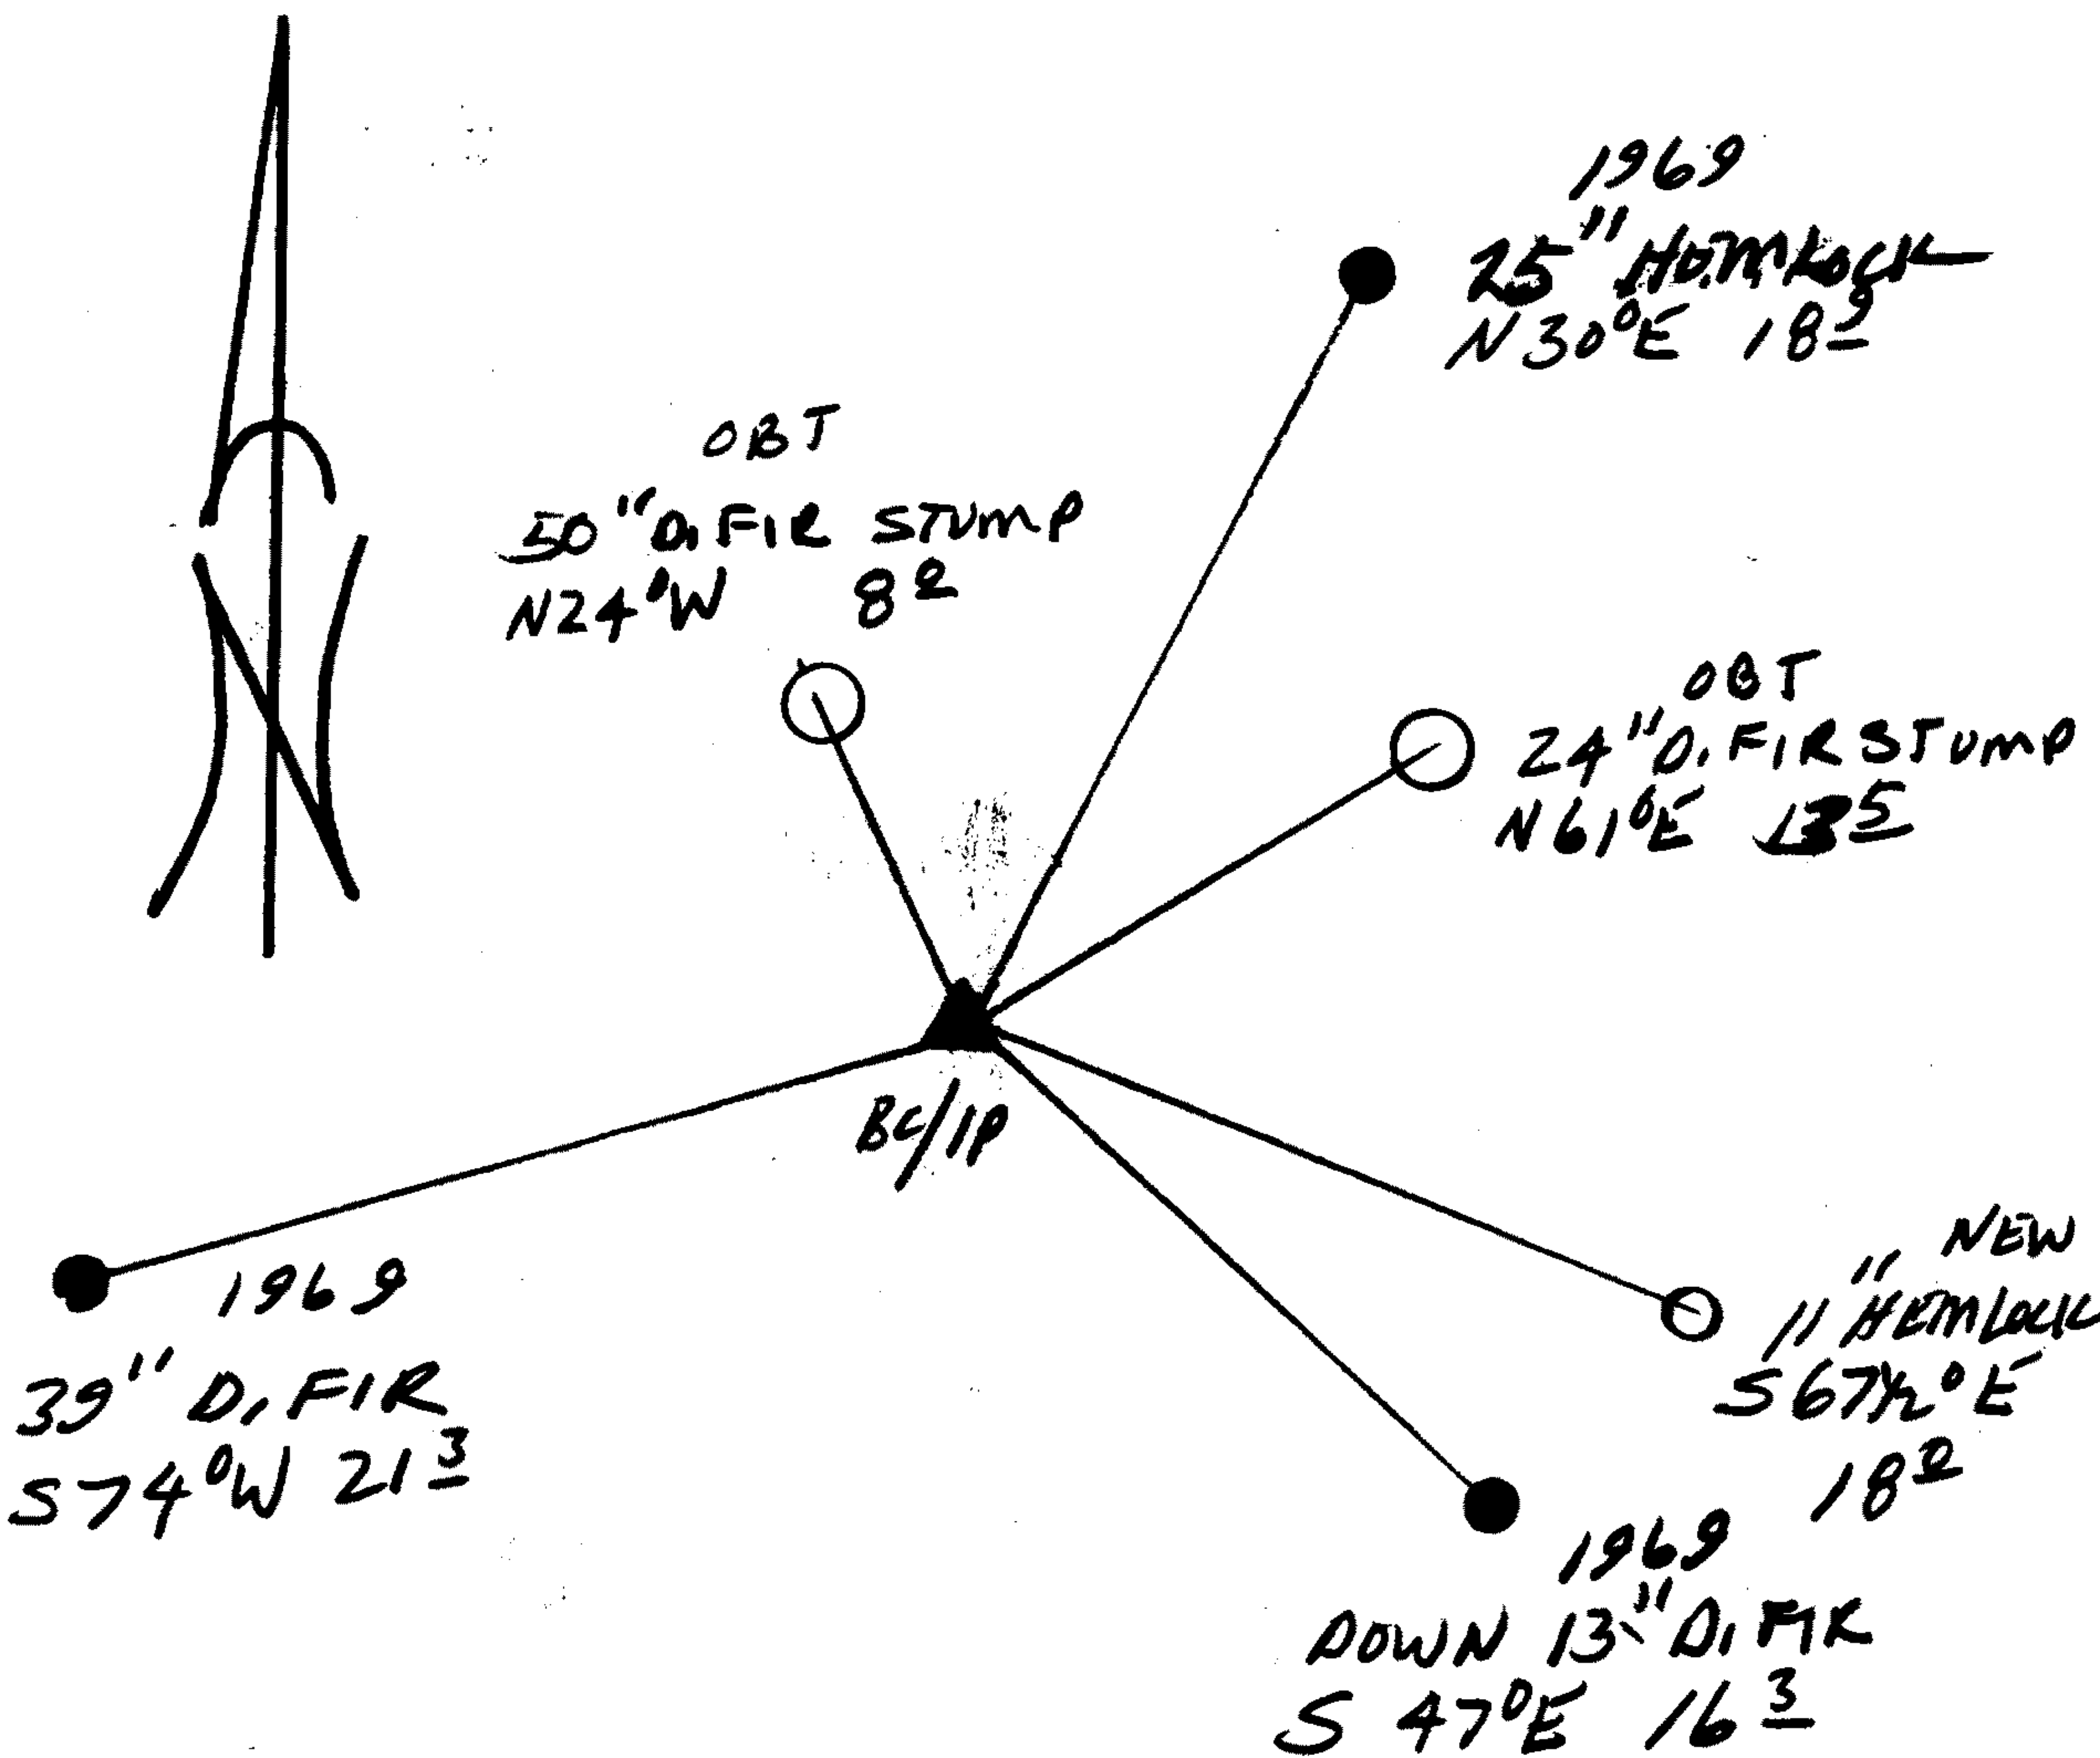

Location & Comments

CORNER LIES ON A
STEEP SOUTH SLOPE
APPROX 50 FT SOUTH
OF A GRAVEL ROAD

FENCE POST PROTRUDING
1/2' ABOVE GROUND BEARS
N20°E, 7 1/2 FT

Comp. Declin. 17 3/4° E
Agency PCSO
Party Chief RANDALL W SMITH
Notekeeper M. GILL
Witnesses STEPHEN J FLAUSK

Address

Surveyor's Seal

REGISTERED
PROFESSIONAL
LAND SURVEYOR

Randall W Smith
EXPIRES 6-30-96

OREGON
JULY 25, 1990
RANDALL W. SMITH
2469