

GOVERNMENT CORNER RESTORATION FORM

Date: 2/8/96 By: BC

Township 29S Range 6W Sec. 16

County DOUGLAS This survey consists of:

State OR Date 2-5-96 No. _____

Map: _____

Narrative: _____

Corner Rpt: CS 64/66

Corner Designation

NE COR
DLC 45

DOUGLAS COUNTY
SURVEYOR
Condition Report Only
 Not Found
 Renewed
 Unrecorded
 Surveyed In
 Referenced Out

PI# 045010

Previous Renewals 1913 CAIN, 1923 COLE, 1954 BYRON

Monument(s) Found: (Condition and Source)

2 1/2" BRASS CAP ON A 1 1/2" O.D.
IRON PIPE PROTRUDES 13" ABOVE
GROUND. 1954 BYRON SMALL
MOUND OF STONE AROUND BASE
OF BR/IR

COUNTY SURVEYORS OFFICE

NE

DLC COR
45 | T29S
R6W
1954

Accessories Found:

12" NOW 25" DIA. N. FIR WITH A FULLY HEALED
DOUBLE BLAZE, BEARS S63 1/2° E 40.0 FT
(AGREES WITH REC) 1954 BYRON

DCSO 1954 (BYRON) 7" W. OAK NOW DEPRESSION
IN GROUND NEAR REL. BRGT DIST (S60° W, 29.1 FT)

NO OTHER BT'S FOUND

RENEWAL

Monument Set (Procedure and Description)

Monument Detail

NONE

N/A

New Accessories


11" DIA. W. OAK DOUBLE BLAZED AND SCRIBED "NE D.C. 45 CS BT."
BEARS S 79 1/2° W, 49.4 FT

19" DIA W. OAK DOUBLE BLAZED AND SCRIBED "NE D.C. 45 CS BT"
BEARS S 10 3/4° E, 110.8 FT

FD 3/8" IR PROTRUDING 12" ABOVE GROUND BEARS S 75 1/4° E, 77.25 FT

Sketch of Monument, Accessories, and General Area

Location & Comments

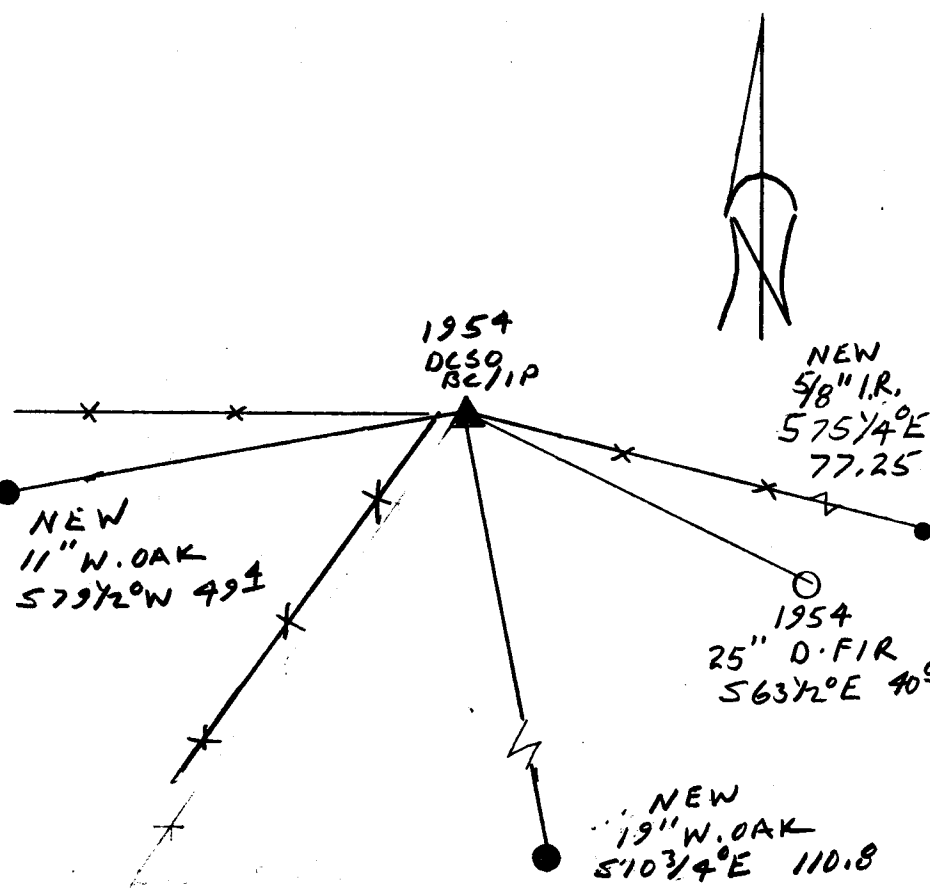

Comp. Declin. 17 3/4° E
 Agency D.C.S.O.
 Party Chief RANDALL W. SMITH
 Notekeeper Randall W. Smith
 Witnesses STEPHEN J. FLAUSE

Address _____

REGISTERED Surveyor's Seal
PROFESSIONAL LAND SURVEYOR
Randall W. Smith
 EXPIRES 6-30-96
 OREGON
 JULY 25, 1990
RANDALL W. SMITH
 2469