

GOVERNMENT CORNER RESTORATION FORM

Township 22S Range 9W Sec. 8

County DOUGLAS Date: 2/20/96 By: BC
This survey consists of:

State OR

Date 12-18-95 No. _____

Map: _____
Narrative: _____
Corner Rpt: CS 64/66-6

Corner Designation

AS DETERMINED BY LOCAL SURVEYORS

DLC
39

Condition Report Only
Not Found
Renewed
 Unrecorded
Surveyed In
Referenced Out

MONUMENT DETAIL

Previous Renewals 1896 GLO, M 42-40, 1995-0109

Monument(s) Found: (Condition and Source)
1" I.D. IRON PIPE PROTRUDING 22" ABOVE GROUND. (SOURCE UNKNOWN)
1" I.P. LEANS 0.4 FT SW OF PLUMB

NOTE: 1" I.P. IS CALLED A 1" I.P. ON SURVEYS OF RECORD

N/A

Accessories Found:

A SEARCH FOR BT'S WAS MADE NONE FOUND. A 40" DIA 8" HIGH NOTED FIR STUMP WAS LOOKED INTO. NO EVIDENCE FOUND THIS STUMP BEARS N 73° E 111.0 FT FROM FOUND IRON PIPE NOTE: 1896 GLO MARKED A 48" DIA FIR THATS BEARING WAS N 72° E 100.3 FT

5/8" IRON ROD PROTRUDING 2" ABOVE GROUND BEARS S 62 1/2° W, 84.4 FT (REC PER M 42-40 S 61 3/4° W, 84.43 FT) WAS SET IN M 42-40 SURVEY

DATE 2-8-96

RENEWAL

Monument Set (Procedure and Description)

Monument Detail

POSITION ~~AND~~ FD I.P. IS REFERENCED AND 2 3/8" DIA BRASS CAP ON A 1 7/8" O.D. 13 1/2" LONG IRON PIPE IS SET AT REFERENCE POSITION. BC/IP PROTRUDES 3" ABOVE GROUND. 1 1/2" I.P. MEASURED 43" LONG IS SET ALONG SOUTH EDGE OF BC/IP PROTRUDES 2" ABOVE GROUND

DOUGLAS COUNTY SURVEYORS

T 22 S
SE COR. | R
DLC 39 | 9
W


1996 OFFICE

NOTE: WE FOUND NO EVIDENCE IN OUR SURVEY FILES OR ON THE GROUND LINKING FD I.P. TO ORIG. SE COR OF DLC 39. WE PERPETUATE I.P. AS AN IMPORTANT POINT OF SURVEY, DENOTED AS THE SE COR. OF DLC 39 ON SEVERAL SURVEY'S.

New Accessories

- 20" DIA. D. FIR DOUBLE BLAZED AND SCRIBED "SE DLC 39 CS BT" BEARS N 67 1/2° E, 3.2 FT.
- 10" DIA. MAPLE DOUBLE BLAZED AND SCRIBED "SE DLC 39 CS BT" BEARS N 21° W, 10.6 FT TO ROOT CROWN.
- 5/8" IRON ROD PROTRUDING 2" ABOVE GROUND BEARS S 62 1/2° W, 84.4 FT
- 14" DIA. D. FIR DOUBLE BLAZED AND SCRIBED "SE DLC 39 CS BT" BEARS N 89° W, 11.2 FT.

Sketch of Monument, Accessories, and General Area

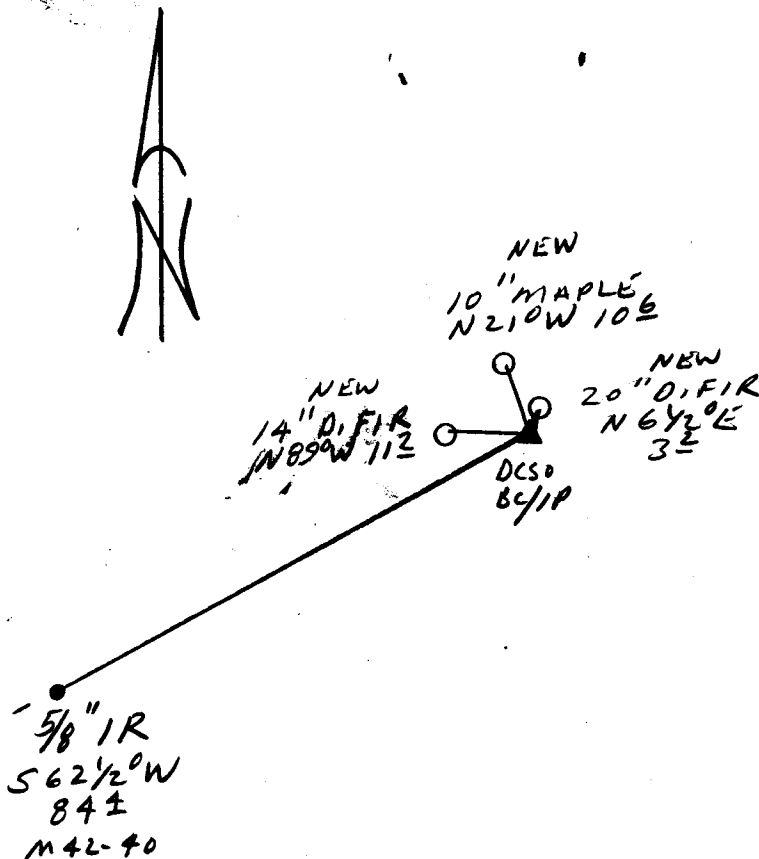

Location & Comments

ORIGINAL CALL OF NORTH, 214.5 FT FROM CORNER AGREES WELL WITH FOUND IRON PIPE.

Comp. Declin. 17 3/4° E
Agency DCSO
Party Chief RANDALL W SMITH
Notekeeper *[Signature]*
Witnesses STEPHEN J FLAUSE

Address

Surveyor's Seal

REGISTERED PROFESSIONAL LAND SURVEYOR

[Signature]
EXPIRES 6-30-98

ORIGON
RANDALL W. SMITH
240