

GOVERNMENT CORNER RESTORATION FORM

Date: 4/25/96 By: AC

Township 32S Range 6W Sec. 31 County DOUGLAS

This survey consists of:

State OR Date 9-15-93 No. _____

Map: _____

Narrative: _____

Corner Designation _____

Corner Rpt: CS 64/166-9

S31 | S32

- DOUGLAS COUNTY
- Cond. Report Only
- Not Found
- Renewed
- Unrecorded
- Surveyed In
- Referenced Out

1855 HYDE + GARDNER COR.

Previous Renewals 49, 64B, 193, 181

Monument(s) Found: (Condition and Source)

5/8" L.R. PROTRUDING 3"
ABOVE GROUND REN #181

N/A

Accessories Found:

NO ORIG BT'S FOUND

6" NOW 12" DIA MADRONE WITH A FULLY HEALED
DOUBLE BLAZE, BEARS N33 1/2° W, 18.1 FT
(REC N26 1/2° W 18.1 FT) REN 49

5" NOW 11" DIA MADRONE WITH A FULLY HEALED
DOUBLE BLAZE, BEARS N26° E, 32.3 FT
(REC N28 1/2° E, 32.3 FT) REN 49

10" NOW 14" DIA. D.FIR WITH A PARTIALLY HEALED DOUBLE
BLAZE, SCRIBING VISIBLE "S BT" BEARS
S58° E, 34.0 FT (AGREES WITH REC) REN #181

8" NOW 10" DIA D.FIR WITH A PARTIALLY HEALED DOUBLE
BLAZE, SCRIBING VISIBLE "3 RS 90 BT", BEARS
S23° W, 24.7 FT (AGREES WITH REC) REN #181

✓ 20010U

RENEWAL

Monument Set (Procedure and Description)

POSITION OF 5/8" I.R. IS REFERENCED
 A 2 3/8" DIA DCSS BRASS CAP ON
 A 1 3/8" O.D BY 32" LONG IRON
 PIPE IS SET AT REFERENCED
 POSITION. BC/IP PROTRUDS 6"
 ABOVE GROUND.

5/8" I.R. MEASURED 3 1/2" LONG,
 IS SET ALONG NORTH EDGE
 OF BC/IP, PROTRUDS 4" ABOVE
 GROUND.


Monument Detail

DOUGLAS COUNTY SURVEYORS OFFICE
 T 32 S
 R 6 W
 S 31 | 532
 T 33 S
 1993

New Accessories

N/A

Sketch of Monument, Accessories, and General Area

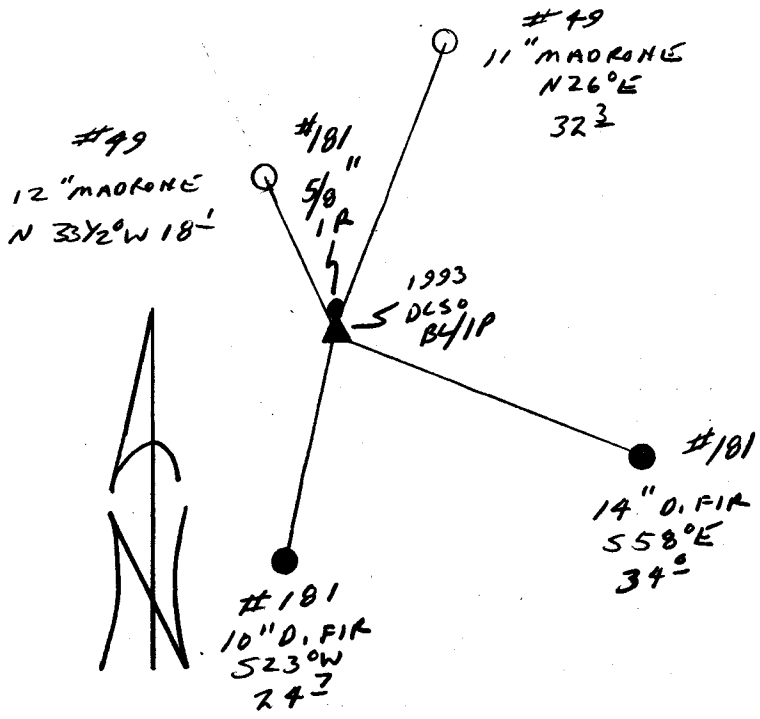

Location & Comments

Comp. Declin. 18° E
 Agency DCSS
 Party Chief RANDALL W SMITH
 Notekeeper Randall W Smith
 Witnesses STEPHEN J FLAUS

Address _____

Surveyor's Seal

REGISTERED
 PROFESSIONAL
 LAND SURVEYOR

Randall W Smith
 EXPIRES 12-31-94

OREGON
 JULY 25, 1990
 RANDALL W. SMITH
 2469