

GOVERNMENT CORNER RESTORATION FORM

Township 27S Range 6W Sec. 7

County DOUGLAS This survey consists of:

Date: 4/26/96 By: PC

State OR Date 4-22-96 No. _____

Map: _____

Narrative: _____

Corner Designation

Corner Rpt: 04/66-13

1/4S7 | S8

- Condition Report Only
- Not Found
- Renewed
- Unrecorded
- Surveyed In
- Referenced Out

MONUMENT DETAIL

Previous Renewals 1960 BYRON (DCSO)

Monument(s) Found: (Condition and Source)

A 2 1/2" DIA. BRASS CAP ON A
1 1/2" O.D. BY 36" LONG IRON
PIPE WAS FOUND OUT OF
GROUND BY PROPERTY OWNER.
(1960 DCSO)

COUNTY SURVEYORS OFFICE
T27S R6W

1/4S7 | S8

1960

Accessories Found:

16" NOW 25" DIA. B. OAK WITH A FULLY HEALED BLAZE
BEARS S55°W, 52.9 FT (REC S55°W 54.8 FT) OBT

12" NOW DOWN AND ROTTED 12" MAPLE, NO SCRIBING
FOUND, ROOTS BEAR N75°E, 21.8 FT (AGGERS
WITH REC.) OBT

20" NOW 26" DIA D. FIR WITH A FULLY HEALED DOUBLE
BLAZE BEARS N14 1/2°E, 19.1 FT (REC N14 1/2°E, 19.8 FT
DIST. A POSSIBLE SLOPE MEASUREMENT) 1960 DCSO

5" NOW 8" DIA B. OAK WITH A FULLY HEALED SINGLE
BLAZE BEARS S62°W, 24.3 FT (AGGERS WITH REC.)
1960 DCSO

RENEWAL

Monument Detail

Monument Set (Procedure and Description)

1960 DCSO BC/IP IS SET AT A POSITION DETERMINED FROM BT'S AS NOTED ON FRONT OF PAGE. BC/IP PROTRUDES 7" ABOVE GROUND. (NOTE WE ADDED STAMPING TO BC "RESET 1996")

COUNTY SURVEYORS OFFICE

T275 R6

1/4 S7 1/8


RESET 1996

1960

New Accessories

12" DIA MADRONE BARK SCRIBED "1/4 S7 CS BT"
BEARS N74°W 25.3 FT

Sketch of Monument, Accessories, and General Area

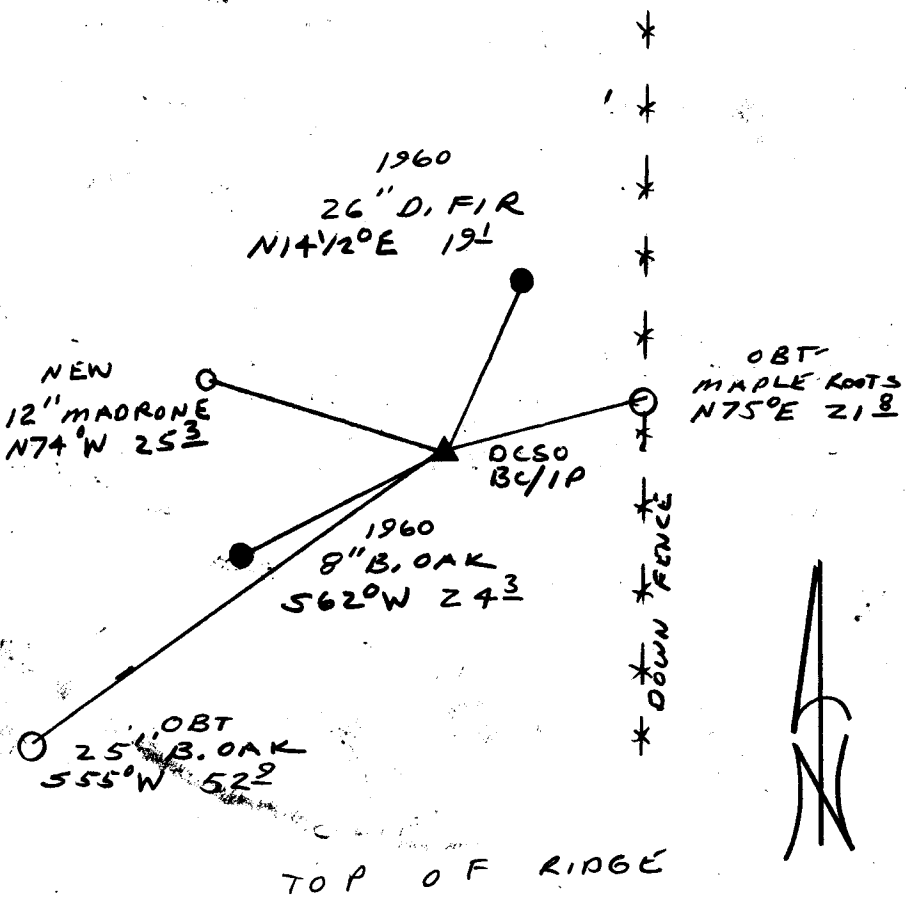

Location & Comments

CORNER LIES ON A STEEP NORTH SLOPE APPROX 20' WEST OF A DOWN NORTH - SOUTH FENCE

Comp. Declin. 17 3/4°
Agency DCSO
Party Chief RANDALL W SMITH
Notekeeper [Signature]
Witnesses STEPHEN J FRAUSE

Address

Surveyor's Seal

REGISTERED PROFESSIONAL LAND SURVEYOR

[Signature]

EXPIRES 6-30-96

OREGON JULY 25, 1990 RANDALL W. SMITH 2469