

GOVERNMENT CORNER RESTORATION FORM

Date: 5/2/96 By: BC

Township 24S Range 7W Sec. 29 County DOUGLAS

This survey consists of:

State OR Date 4-30-96 No.

Map:

Narrative:

Corner Rpt: CS 64/66-15

Corner Designation

RENEWED A POSITION FOR CORNER AS DETERMINED BY RENEWAL #110 AND MONUMENTED BY 1/4 S29 REN #147 1/4 S32

DOUGLAS COUNTY SURVEYOR

- Condition Surveyed
- Not Found
- Renewed
- Unrecorded
- Surveyed In
- Referenced Out

Previous Renewals #2 #110 #147 #163

Monument(s) Found: (Condition and Source)

5/8" I.R. PROTRUDES 5" ABOVE GROUND (#147)

N/A

Accessories Found:

13" NOW 33" DIA D.FIR WITH A FULLY HEALED SINGLE BLAZE BEARS S 81° W, 50.4 FT (AGREES WITH REC.) REN #110

16" DIA OAK NOW DOWN, ROOT HOLE AGREES WITH REC. BKG + DIST (N 63Y2° W 110.3 FT) REN #110

NO OTHER BT'S FOUND

Monument Set (Procedure and Description)

NONE I.R. FALLS DIRECTLY
BELOW AN EAST - WEST
FENCE

N/A


New Accessories

10" DIA. ALDER BARK SCRIBED "1/4 529CS BT"
BEARS N 84°E, 407.9 FT TO ROOT CROWN.

6" DIA. D. FIR DOUBLE BLAZED AND SCRIBED "1/4 529CS BT"
BEARS N 6 1/2°W, 117.7 FT.

14" DIA. W. OAK DOUBLE BLAZED AND SCRIBED "1/4 529CS BT"
BEARS N 65 3/4°W, 131.0 FT.
Sketch of Monument, Accessories, and General Area

Location & Comments

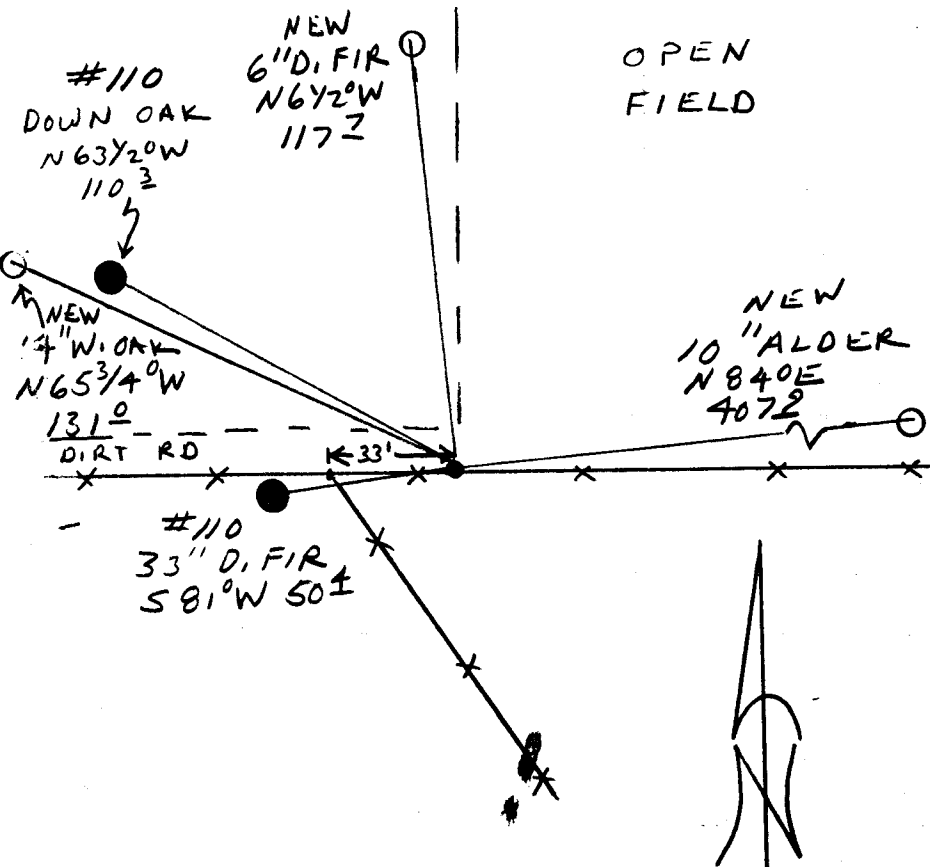

Comp. Declin. 173/4°E
 Agency DCSO
 Party Chief RANDALL W. SMITH
 Notekeeper Randall W. Smith
 Witnesses STEPHEN J. FLANKE

Address

Surveyor's Seal

REGISTERED
 PROFESSIONAL
 LAND SURVEYOR

Randall W. Smith
 APR 6-30-96

OREGON
 JULY 25, 1990
 RANDALL W. SMITH
 2469