

GOVERNMENT CORNER RESTORATION FORM

Date: 5-7-96 By: JC

This survey consists of:

Township 255 Range 4W Sec. 9 County DOUGLAS

Map: _____

State OR Date 5-6-96 No. _____

Narrative: _____

Corner Rpt: CS 64/66-16

Corner Designation AS DETERMINED BY M22-18

DOUGLAS COUNTY SURVEYOR

Condition Report Only

Not Found

Renewed

Unrecorded

Surveyed In

Referenced Out

MONUMENT DETAIL

N.N.W
DLC
49

Previous Renewals M22-18, 1965 DCSG

Monument(s) Found: (Condition and Source)

A 1" DIA. BY 32" LONG AXEL
WITH A 3" DIA GEAR IS FOUND
OUT OF GROUND (M22-18)

N/A

Accessories Found:

21" NOW 28" DIA DOWN D.F.I.R. APPEARS THAT TREE TWISTED
AS IT WENT DOWN, A FULLY HEALED DOUBLE BLAZE (FALLS NORTH)
N 64° E, 4.2 FT IS PER 1965 DCSO RECORD. WE WERE
UNABLE TO DETERMINE A POSITION FOR THIS BT. (1965 DCSO)

10" NOW 14" DIA. D.F.I.R. WITH A FULLY HEALED
DOUBLE BLAZE, BEARS N 26° W, 17.3 FT (AGREES
WITH 1965 DCSO REC.) (1965 DCSO)

NO EVIDENCE OBT'S FOUND

RENEWAL

Monument Detail

Monument Set (Procedure and Description)

POSITION OF CORNER DETERMINED FROM DCSO 1265 NORTH WEST BT.

2 3/8" DIA BRASS CAPON A 1 3/8" DIA. BY 32" LONG IRON PIPE PROTRUDES 10" ABOVE GROUND. AXLE IS SET ALONG SOUTH EDGE OF BC/IP PROTRUDES 8" ABOVE GROUND.

BC/IP AND AXLE ARE SET IN LARGE ROOT HOLE, NEAR ITS WESTERLY EDGE.

DOUGLAS COUNTY SURVEYORS
T 255
NNW R
DLC 49 4 W
1996
OFFICE


New Accessories

11" DIA. D.FIR DOUBLE BLAZED AND SCRIBED "NNW DLC 49 CS BT"
BEARS N 81 1/2° W, 6.0 FT

4" DIA. D.FIR DOUBLE BLAZED AND SCRIBED "X BT"
BEARS S 29 1/2° W, 20.9 FT

7" DIA. D.FIR DOUBLE BLAZED AND SCRIBED "NNW DLC 49 CS BT"
BEARS S 9° E, 30.6 FT

Sketch of Monument, Accessories, and General Area

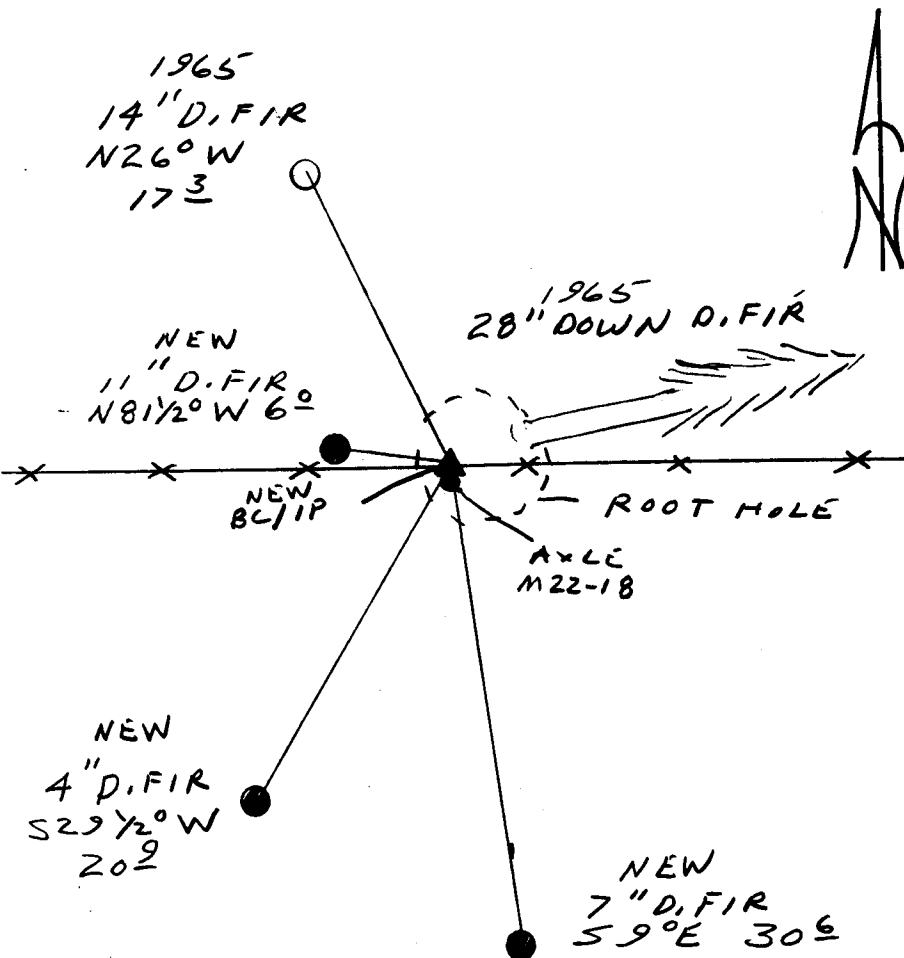

Location & Comments

Comp. Declin. 17 3/4° E
Agency DCSO
Party Chief RANDALL W. SMITH
Notekeeper R. GILL W. J. H.
Witnesses STEPHEN T. FAUSL

Address

Surveyor's Seal

REGISTERED
PROFESSIONAL
LAND SURVEYOR

Randall W. Smith
EXPIRES 6-30-96

OREGON
JULY 25, 1990
RANDALL W. SMITH
2469