



RENEWAL

Monument Set (Procedure and Description)

Monument Detail

NONE


N/A

New Accessories

- 8" DIA. D. FIR DOUBLE BLAZED AND SCRIBED "1/4 S22 CS BT" BEARS N29 1/2° E, 13.4 FT.
- 9" DIA. D. FIR DOUBLE BLAZED AND SCRIBED "1/4 S22 CS BT" BEARS N48 1/2° W, 19.2 FT
- 3" CEDAR DOUBLE BLAZED AND SCRIBED "X BT", BEARS S75 3/4° W, 16.7 FT
- 36" DIA 2 FT HIGH D. FIR STUMP WITH 8" BOAT SPIKE THROUGH A BT TAG SET THROUGH TOP CENTER OF NEAR CENTER OF STUMP. BOAT SPIKE BEARS S84° E 22.1 FT

Sketch of Monument, Accessories, and General Area

Location & Comments

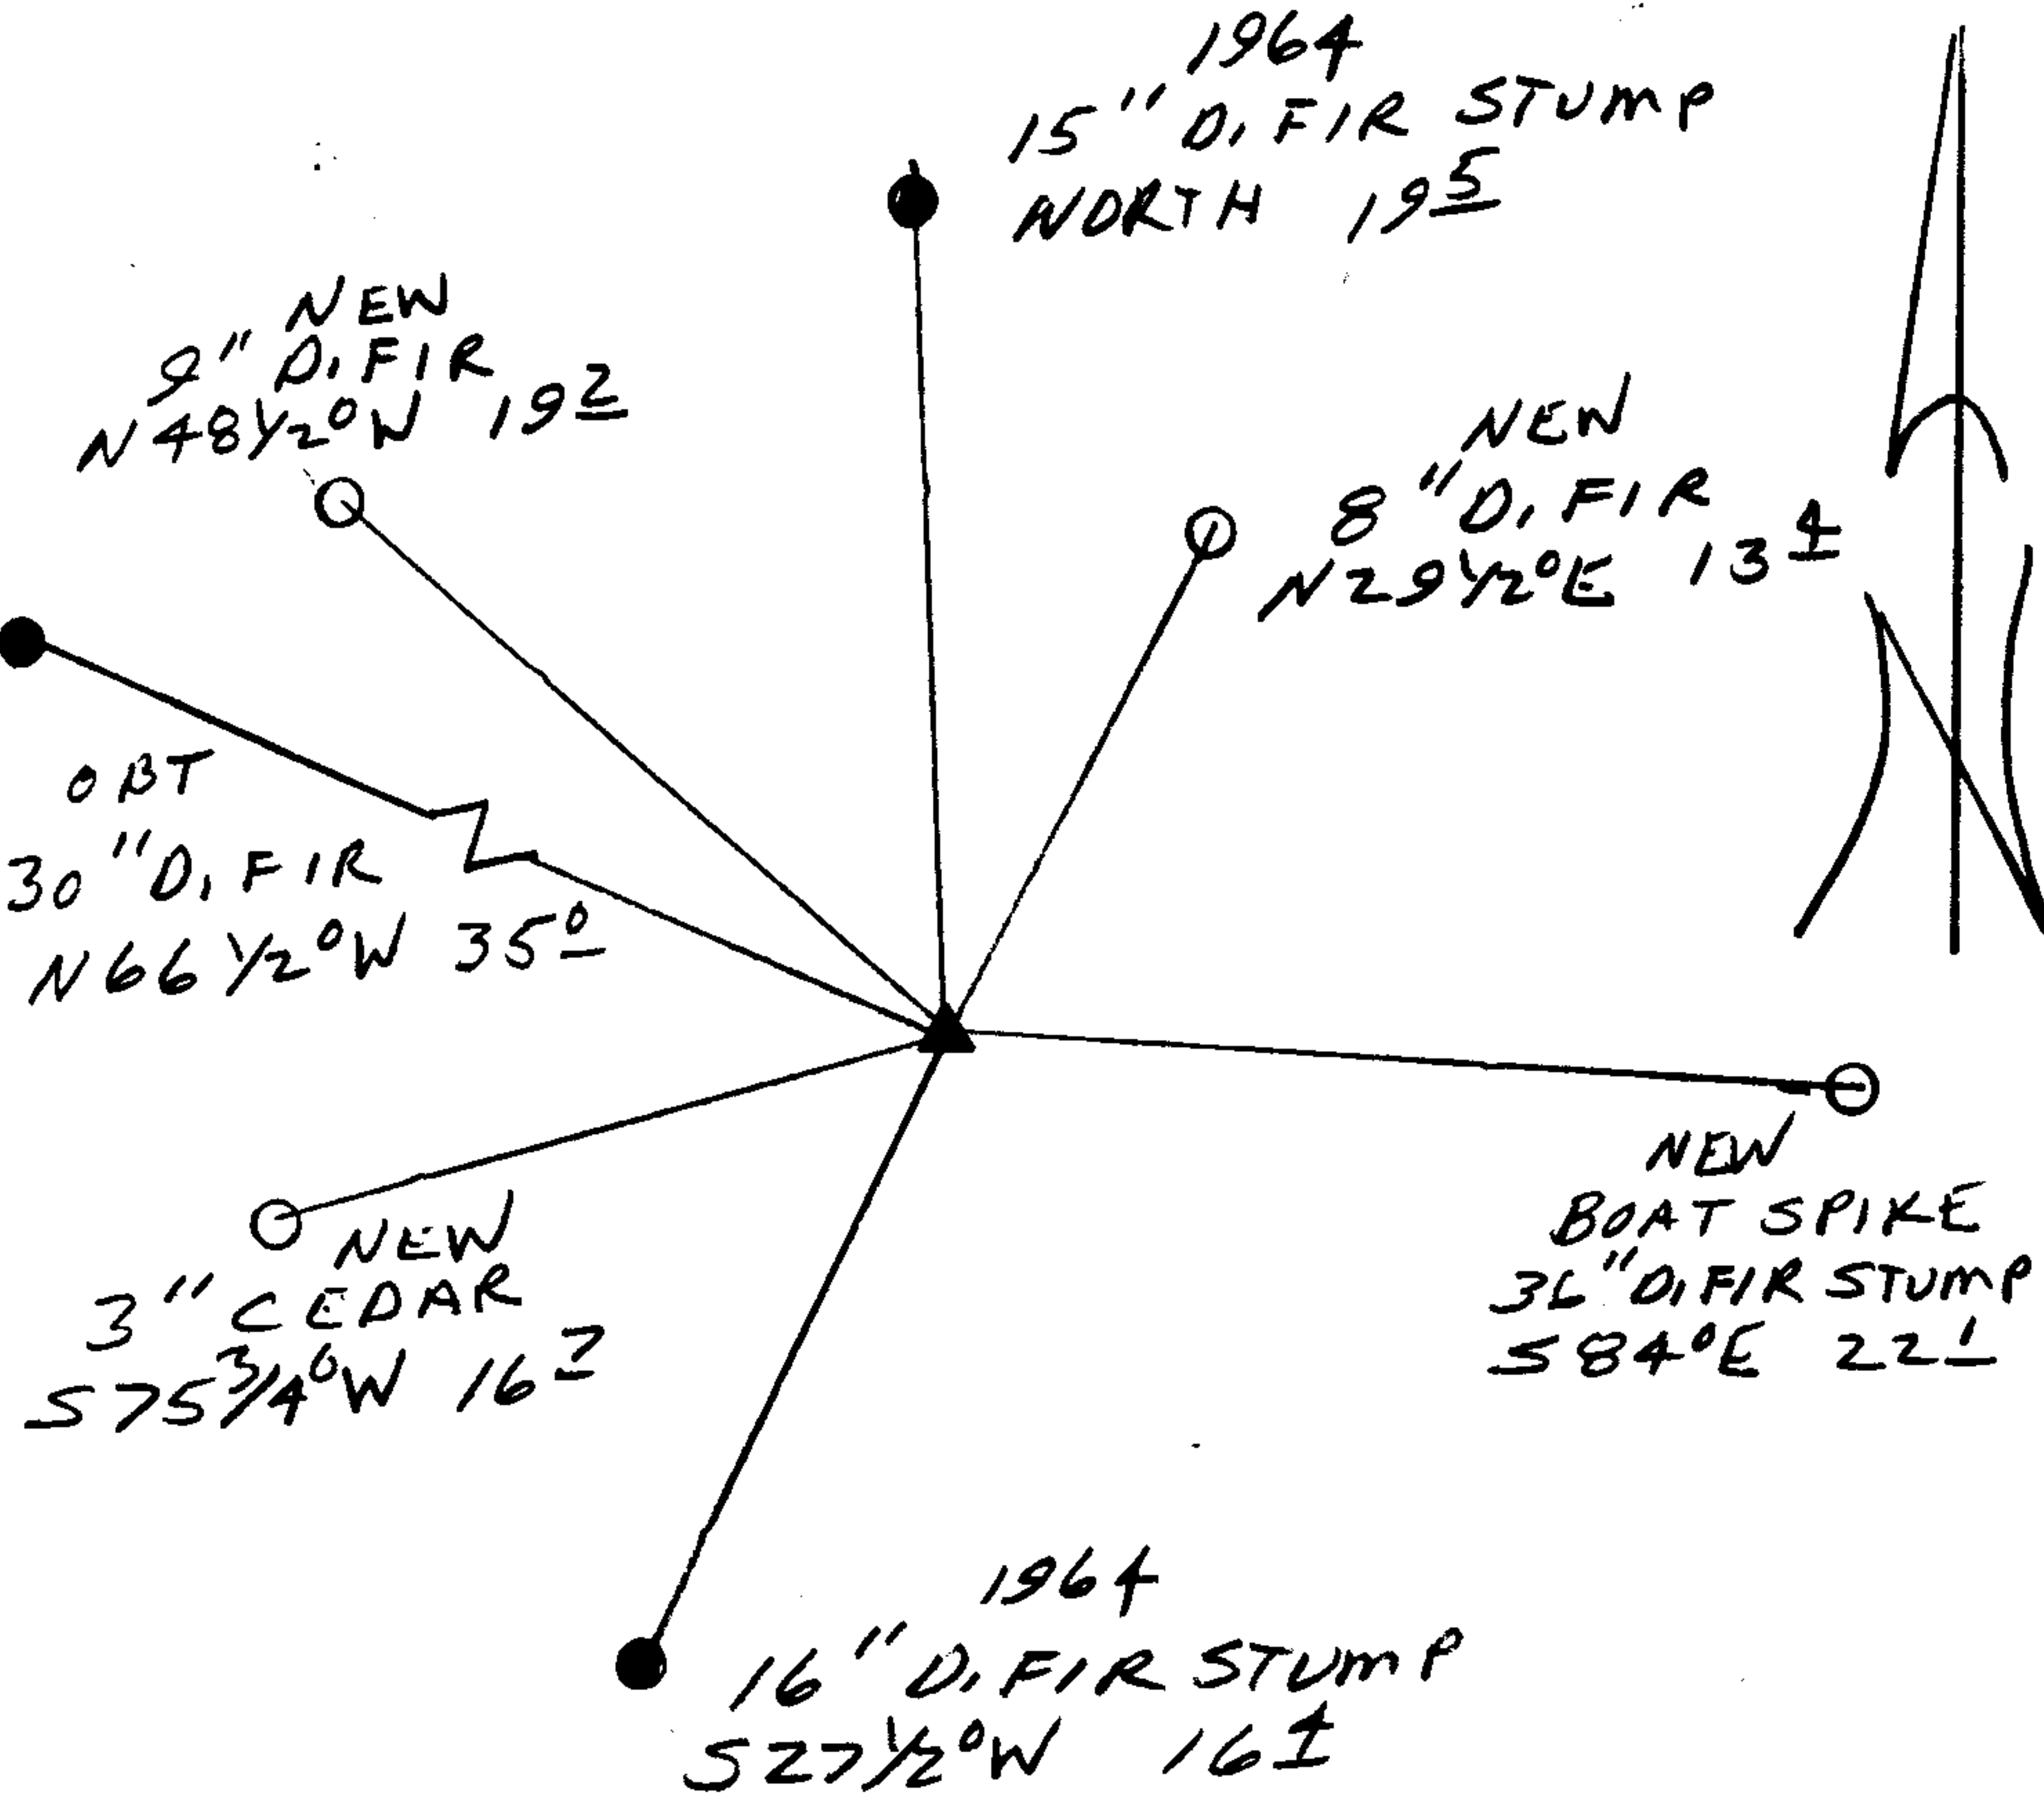

Comp. Declin. 17 3/4° E  
 Agency DCSO  
 Party Chief RANDALL W SMITH  
 Notekeeper Randall W Smith  
 Witnesses STEPHEN J FLAUSE

Address

Surveyor's Seal

REGISTERED  
 PROFESSIONAL  
 LAND SURVEYOR

*Randall W Smith*  
 EXPIRES 6-30-96

OREGON  
 JULY 25, 1990  
 RANDALL W. SMITH  
 2409