

GOVERNMENT CORNER RESTORATION FORM

Date: 6/13/96 By: RC

This survey consists of:

Township 26S Range 7W Sec. 23 County DOUGLAS  
State OR Date 5-2-96 No. \_\_\_\_\_

Narrative: \_\_\_\_\_  
Corner Rpt: 64/69-3

Corner Designation

1/4 523 | 524

DOUGLAS COUNTY SURVEYOR

- Condition Report Only
- Not Found
- Renewed
- Unrecorded
- Surveyed In
- Referenced Out

Previous Renewals 1970 DCSO

Monument(s) Found: (Condition and Source)

2 1/2" BRASS CAP ON A 1 1/2" OD. IRON PIPE PROTRUDING 8" ABOVE GROUND (1970 DCSO)

COUNTY SURVEYORS OFFICE

T 26S  
1/4 S | S  
23 | 24  
R 7W  
1970

Accessories Found:

10" NOW 24" DIA. 2' HIGH ROTTED OAK STUMP NO EVIDENCE OF BLAZES OR SCRIBING VISIBLE, BEARS N 55° W, 19.8 FT (AGREES WITH REC) OBT

9" W. OAK NOW 20" DIA. B. OAK WITH A FULLY HEALED BLAZE BEARS N 44° W, 62.5 FT. (REC N 46° W, 62.5 FT) 1970 DCSO

10" NOW 25" DIA. W. OAK WITH A FULLY HEALED DOUBLE BLAZE, BEARS S 1° W, 54.2 FT (REC S 1° E, 54.2 FT) 1970 DCSO

NOTE

5/8" I. R. (REC. N 88° E 20.5 FT PER 1970 DCSO RENEWAL) NOT LOOSED FOR

RENEWAL

Monument Set (Procedure and Description)

Monument Detail

NONE

N/A


New Accessories

15" B. OAK DOUBLE BLAZED AND SCRIBED "Y4S23CSBT"  
BEARS N10°W, 51.8 FT

13" GRAND FIR. DOUBLE BLAZED AND SCRIBED "Y4S23CSBT"  
BEARS N79 1/2°W, 96.8 FT

Sketch of Monument, Accessories, and General Area

Location & Comments

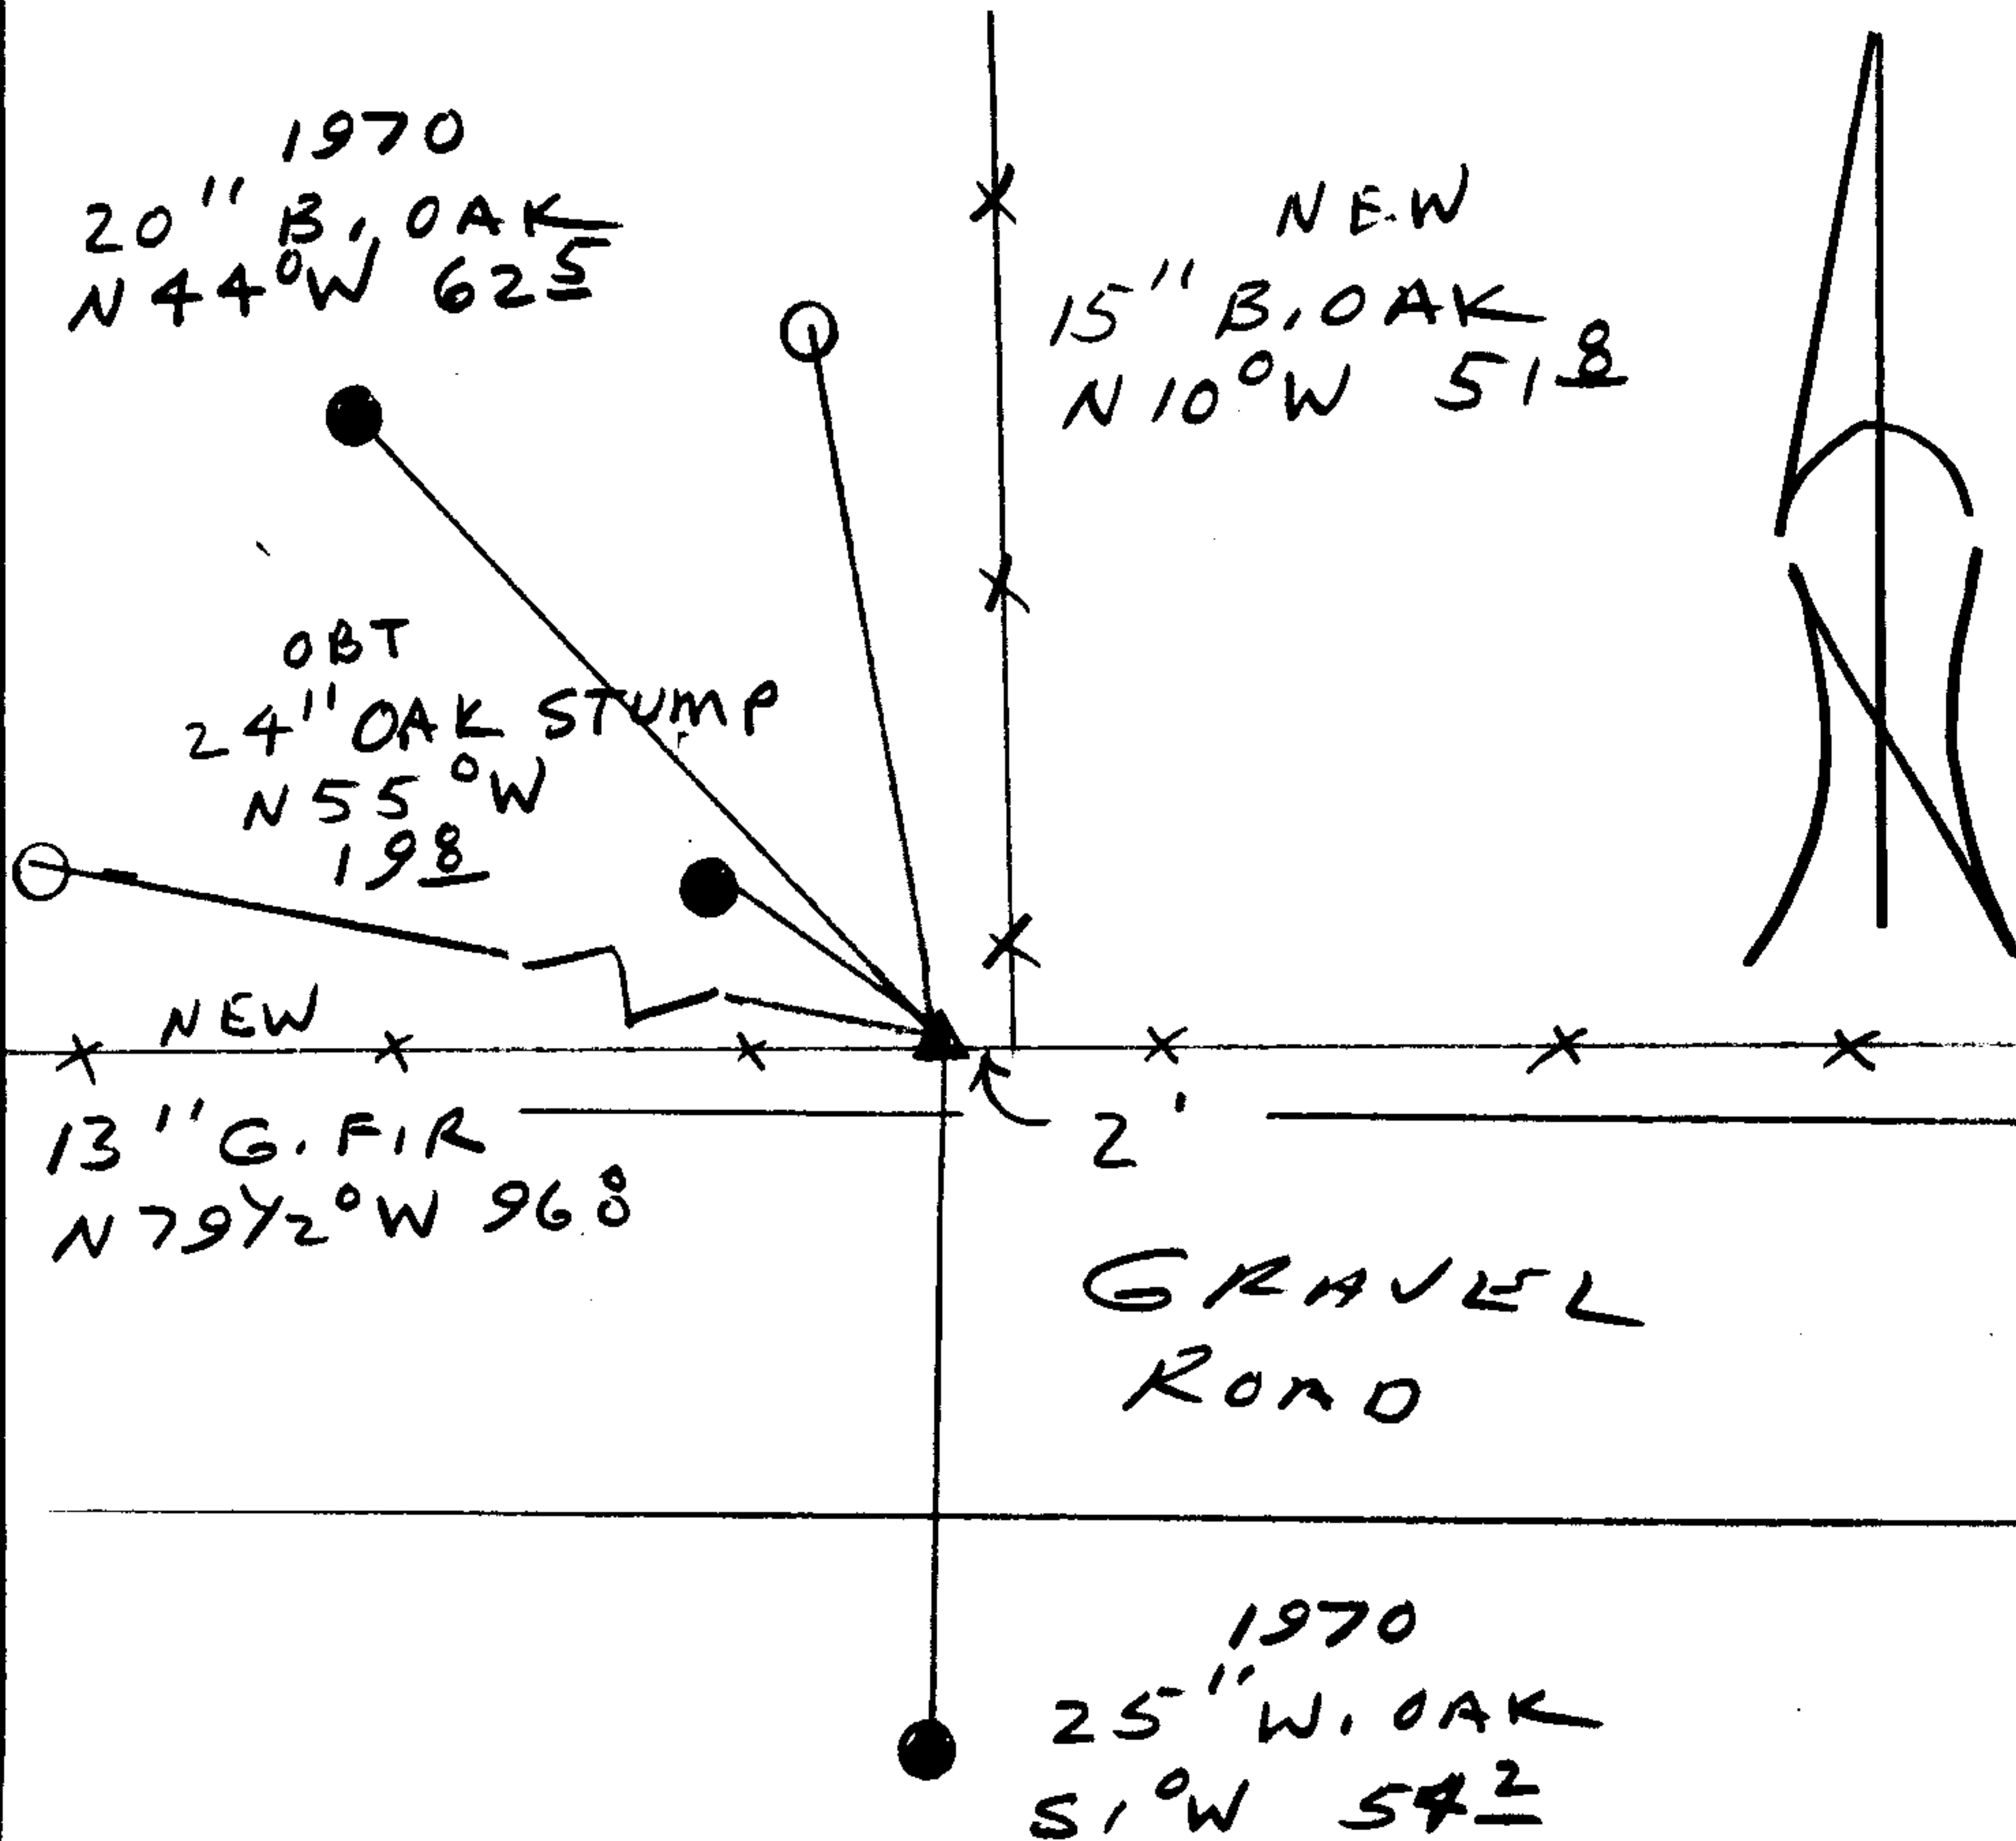

Comp. Declin. 17 3/4° E  
 Agency DCSG  
 Party Chief RANDALL W. SMITH  
 Notekeeper Randall W. Smith  
 Witnesses STEPHEN J. FLAUS

Address

Surveyor's Seal

REGISTERED  
 PROFESSIONAL  
 LAND SURVEYOR

*Randall W. Smith*  
 EXPIRES 6-30-96

OREGON  
 JULY 25, 1990  
 RANDALL W. SMITH  
 2489