



RENEWAL

Monument Detail

Monument Set (Procedure and Description)

BC/IP IS SURROUNDED BY  
A 2 FT DIA. MOUND OF STONE.


N/A

New Accessories

11" DIA. D. FIR DOUBLE BLAZED AND SCRIBED "1/4 S 14 CS BT"  
BEARS N 8 1/2° E, 21.4 FT.

9" DIA. D. FIR DOUBLE BLAZED AND SCRIBED "1/4 S 15 CS BT"  
BEARS N 25 1/2° W, 14.7 FT.

Sketch of Monument, Accessories, and General Area

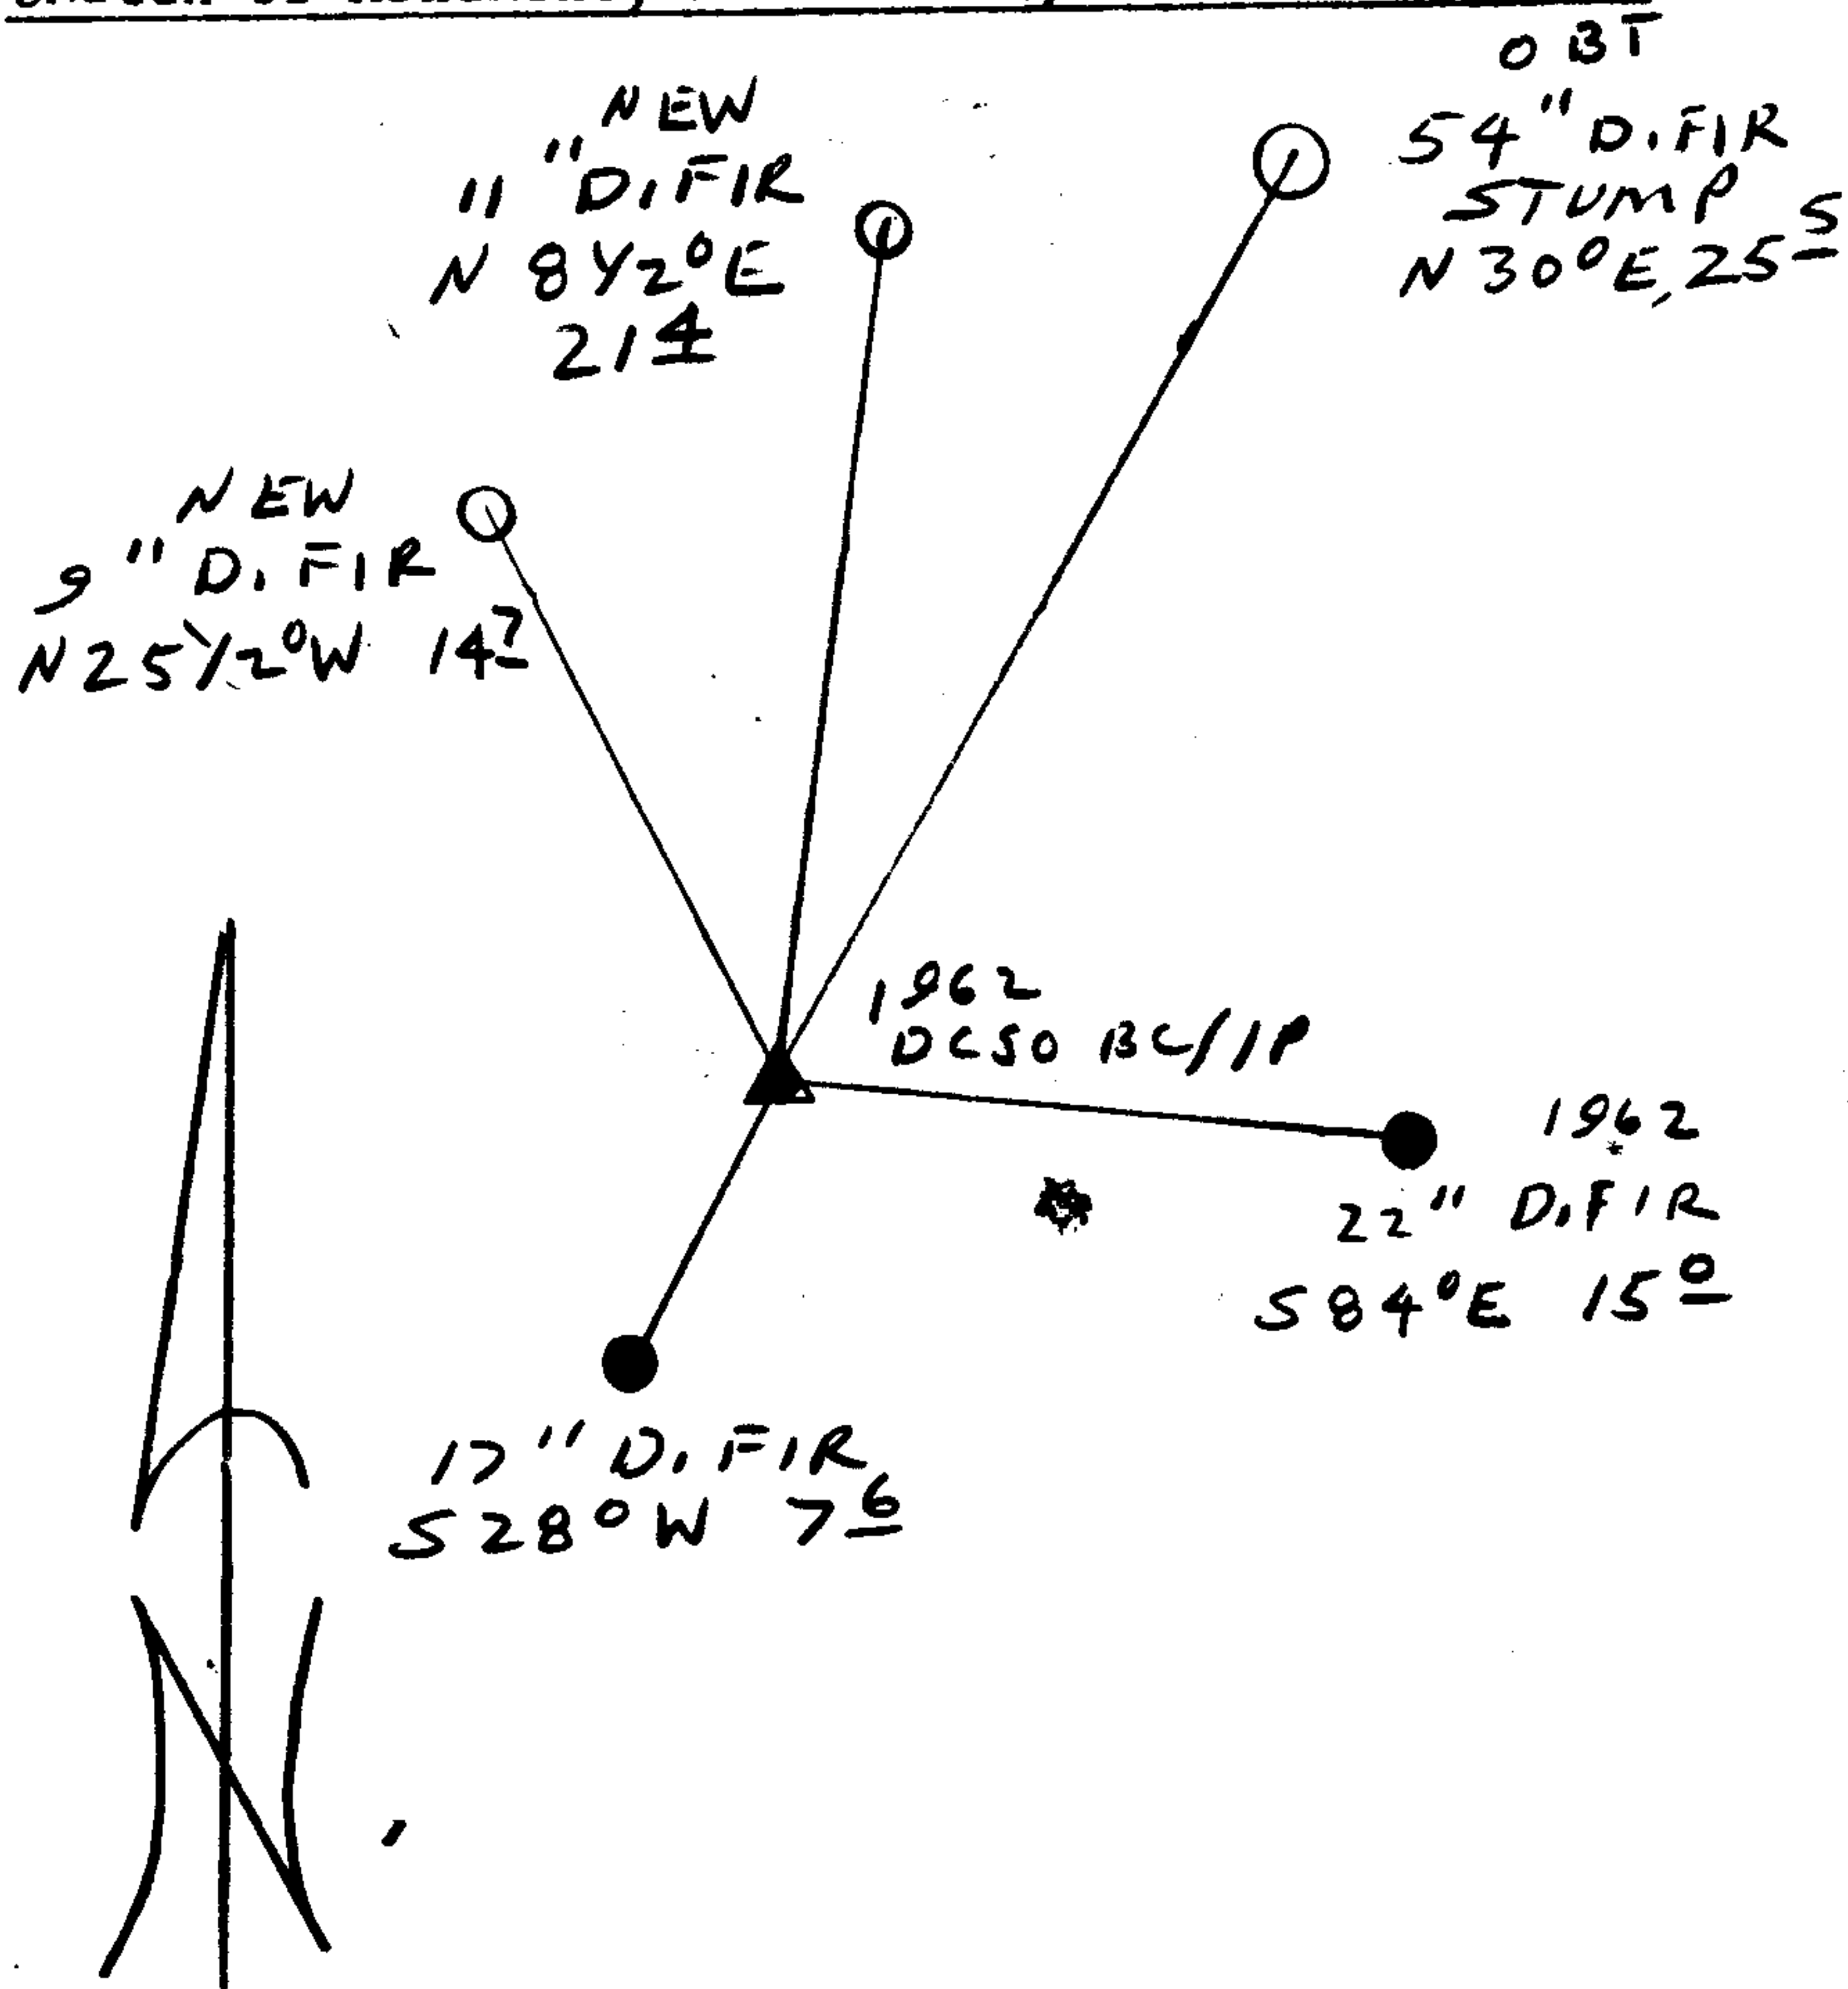

Location & Comments

Comp. Declin. 17 3/4° E  
Agency DCSO  
Party Chief RANDALL W. SMITH  
Notekeeper Randall W. Smith  
Witnesses STEPHEN J. FLAUSE

Address

Surveyor's Seal

REGISTERED  
PROFESSIONAL  
LAND SURVEYOR

*Randall W. Smith*  
EXPIRES 6-30-96

OREGON  
JULY 25, 1990  
RANDALL W. SMITH  
2489