

GOVERNMENT CORNER RESTORATION FORM

Date: 6/25/96 By: RC

This survey consists of:

Township 25S Range 7W Sec. 35

County DOUGLAS Map: _____

State OR Date 6-18-96

No. _____ Narrative: _____

Corner Rpt: 64/69-7

Corner Designation

NE COR DLC 47	WNW DLC 44
---------------------	------------------

DOUGLAS COUNTY SURVEYOR

- Condition Report Only
- Not Found
- Renewed
- Unrecorded
- Surveyed In
- Referenced Out

Previous Renewals 1966 DCSO PI# 044040

Monument(s) Found: (Condition and Source)

6" X 18" STONE PROTRUDES 6"
ABOVE GROUND, NO MARKS
VISIBLE (SOURCE UNKNOWN)

1/2" DIA. BRASS CAP ON A 1/2" O.D.
IRON PIPE PROTRUDES 12" ABOVE
GROUND

BC/IP BEARS S50°W, 0.7 FT
FROM CORNER STONE

Accessories Found:

COUNTY SURVEYORS OFFICE T25S

N.E. COR. DLC. 47	T	W.S.W. COR. DLC. 44
----------------------------	---	------------------------------

R7W
1966

O.B.T. NOW GONE

27" NOW 29" DIA W. OAK WITH A FULLY HEALED SINGLE
BLAZE BEARS S88°E, 41.6 FT FROM CORNER STONE
(AGREES WITH REC) 1966


NOTE:
1966 DCSO RENEWAL INDICATES THIS BT AS
BEING Scribed "S SW DLC 44 CS BT" SHOULD
BE WNW DLC 44 CS BT.

RENEWAL

Monument Set (Procedure and Description)

Monument Detail


1966 DCSO BC/1P MARKED AS
 WSW COR DLC 44 NE
 CHANGE TO WNW COR DLC 44

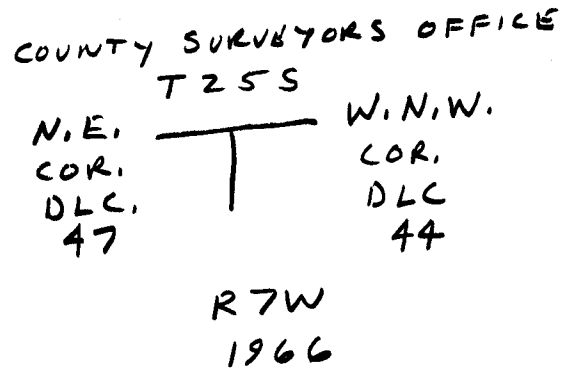

BRG + DIST'S TAKEN FROM CORNER STONE

New Accessories

- 13" DIA. B. OAK DOUBLE BLAZED AND SCRIBED "NE DLC 47 CS BT" BEARS N 41° E, 30.1 FT.
 - 12" DIA. O. ASH DOUBLE BLAZED AND SCRIBED "NE DLC 47 CS BT" BEARS N 0 1/2° W, 77.8 FT
 - 10" DIA. B. OAK DOUBLE BLAZED AND SCRIBED "NE DLC 47 CS BT" BEARS N 14° W, 9.4 FT
- Sketch of Monument, Accessories, and General Area

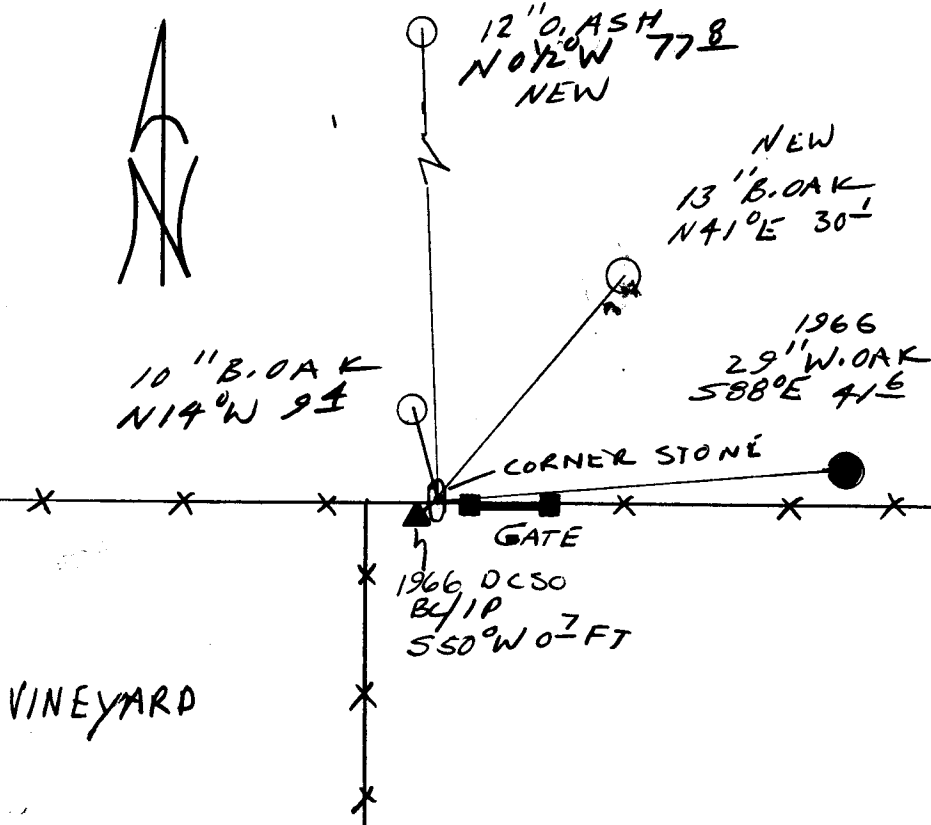

Location & Comments

CORNER LIES 6.5 FT EAST OF A THREWAY FENCE CORNER RUNNING EAST-WEST AND A NEW FENCE THAT RUNS SOUTH

ROTTED REMAINS OF AN OLD FENCE CORNER 4 FT WEST OF CORNER (NOTED IN 1966)

Comp. Declin. 17 3/4° E
 Agency DCSO
 Party Chief RANDALL W. SMITH
 Notekeeper [Signature]
 Witnesses STEPHEN J. FLAUSE

Address

Surveyor's Seal

REGISTERED PROFESSIONAL LAND SURVEYOR

[Signature]

EXPIRES 6-30-96

OREGON
 JULY 25, 1990
 RANDALL W. SMITH
 2489

VINEYARD