

GOVERNMENT CORNER RESTORATION FORM

Date: 7-31-96 By: PC

Township 25 Range 7W Sec. _____

County DOUGLAS This survey consists of:

State OR Date 7-18-96 No. _____

Map: _____

Narrative: _____

Corner Designation

Corner Rpt: C5 64/69-11

NW COR
DLC 48

- DOUGLAS COUNTY SURVEYOR
- Condition Report Only _____
 - Not Found _____
 - Renewed
 - Unrecorded _____
 - Surveyed In _____
 - Referenced Out _____

MONUMENT DETAIL

Previous Renewals 1965 DCSO PI# 048020

Monument(s) Found: (Condition and Source)

2 1/2" DIA. BRASS CAP ON A 1 1/2" OD IRON PIPE, PROTRUDES 8" ABOVE GROUND, (1965)

ROTTED WOODEN POST WITH TACK IN TOP PROTRUDES 8" ABOVE GROUND, 0.5 FT EAST OF BC/PL

COUNTY SURVEYORS OFFICE
T 25 S

R
7
W

NW
DLC
48

1965

Accessories Found:

18" B. OAK NOW ROOT HOLE BEARS S50°E, 31.7 FT (AGREES WITH REC.) OBT

14" NOW 20" DIA. T CEDAR WITH A FULLY HEALED DOUBLE BLAZE, BEARS S7°W, 18.3 FT (AGREES WITH REC.) 1965

25" NOW 29" DIA. D. FIR WITH A FULLY HEALED DOUBLE BLAZE, BEARS N7°E, 8.8 FT (AGREES WITH REC.) 1965

Monument Set (Procedure and Description)

Monument Detail

NONE

N/A


New Accessories

14" DIA. D. FIR DOUBLE BLAZED AND SCRIBED "NW DLC 48 CS BT"
BEARS S 76 1/2° E, 29.2 FT

13" DIA PISTOL BUTT MAPLE DOUBLE BLAZED AND SCRIBED
"NW DLC 48 CS BT" BASE OF SCRIBED TRUNK
BEARS N 62° E, 37.3 FT

Sketch of Monument, Accessories, and General Area

SE QUAD
LOGGED

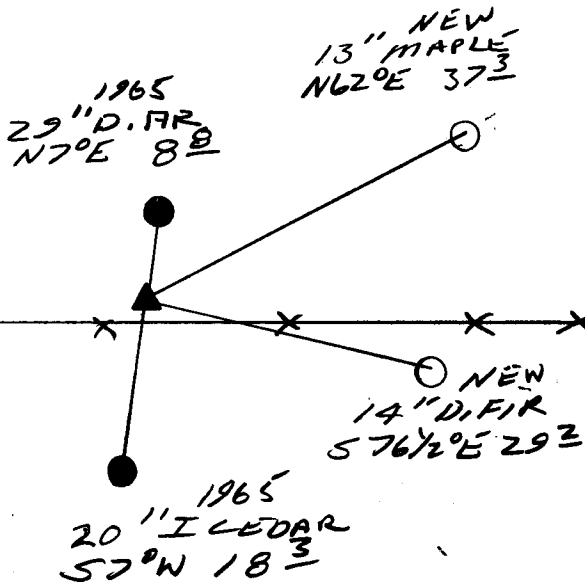

Location & Comments

CORNER LIES NORTH 2.5 FT
FROM AN EAST-WEST
FENCE LINE.

Comp. Declin. 17 3/4° E
Agency DCSO
Party Chief RANDALL W. SMITH
Notekeeper [Signature]
Witnesses STEPHEN J. FLAUS

Address

Surveyor's Seal

REGISTERED
PROFESSIONAL
LAND SURVEYOR

[Signature]
EXPIRES 6-30-99

OREGON
JULY 25, 1990
RANDALL W. SMITH
2469