

GOVERNMENT CORNER RESTORATION FORM

Date: 8.1.96 By: PC

This survey consists of:

Township 31S Range 6W Sec. 36 County DOUGLAS Map: \_\_\_\_\_

State OR Date 7-24-96 No. \_\_\_\_\_ Narrative: \_\_\_\_\_

Corner Apt: CS 64/169-15

Corner Designation

$\frac{1}{4} \frac{S36}{S1}$

DOUGLAS COUNTY SURVEYOR

Condition Report Only

Not Found

Renewed

Unrecorded

Surveyed In

Referenced Out

MONUMENT DETAIL

PI# 640100

Previous Renewals 1959 AND 1966 DCSSO

Monument(s) Found: (Condition and Source)

2 1/2" BRASS CAP ON A 1 1/2" O.D. IRON PIPE, LEANING 12" SOUTH OF PLUMB, PROTRUDING 15" ABOVE GROUND. (1966 DCSSO)

COUNTY SURVEYORS OFFICE  
T 31S R 6W

$\frac{1}{4} S \frac{S36}{S1}$   
T 32S  
1966

Accessories Found:

12" NAW 14" DIA. LIVE OAK WITH A FULLY HEALED DOUBLE BLAZE, BEARS N66°W, 17.3 FT (REC N64°W 17.3 FT) 1959 DCSSO

N5°W 13T FROM 1959 RENEWAL FALLS IN CAT ROAD

NO OBT'S FD

Monument Set (Procedure and Description)

BC/IP RETURNED TO PLUMB  
POSITION IS SURROUNDED BY A  
2 FT DIA MOUND OF STONE.

N/A

Accessories

21" DIA. D. FIR DOUBLE BLAZED AND SCRIBED "1/4 S1 CS BT"  
BEARS S48 1/2° W, 44.0 FT.

7 1/2" DIA LIVE OAK DOUBLE BLAZED AND SCRIBED "1/4 S36 CS BT"  
BEARS N85° W, 16.7 FT

8" DIA LIVE OAK DOUBLE BLAZED AND SCRIBED "1/4 S1 CS BT"  
BEARS S67° W, 25.4 FT

Sketch of Monument, Accessories, and General Area

Location & Comments

PERPETUATED A POINT SET  
BY GEORGE WENDERATH IN 1859  
THAT HE DETERMINED TO BE  
THE 1/4 CORNER.

Comp. Declin. 17 3/4° E


Agency DCSO

Party Chief RANDALL W. SMITH

Notekeeper R. G. W. Smith

Witnesses STEPHEN J. FLAISE

Address

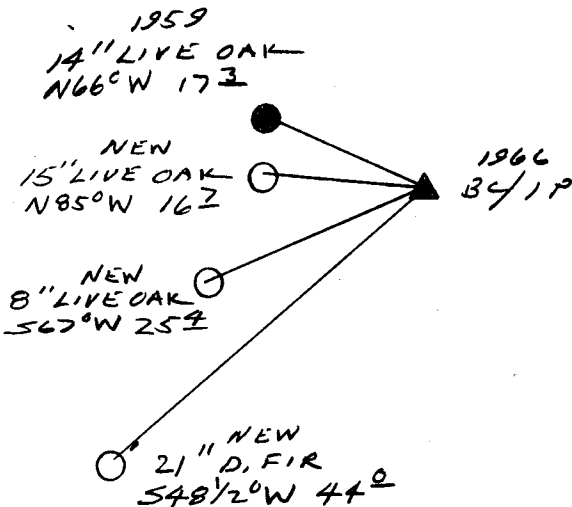

Surveyor's Seal

REGISTERED  
PROFESSIONAL  
LAND SURVEYOR

Randall W. Smith  
EXPIRES 6-30-98

OREGON  
JULY 25, 1980  
RANDALL W. SMITH  
2489