

GOVERNMENT CORNER RESTORATION FORM

Date: 8/7/96 By: P.C.

Township 3/S Range 6W Sec. 29 County DOUGLAS Map: _____

This survey consists of: _____

State OR Date 8-5-96 No. _____

Narrative: _____

Corner Rpt: 64/69-17

Corner Designation

S30	S29
S31	S32

DOUGLAS COUNTY

Condition Surveyed Only

Not Found

Renewed

Unrecorded

Surveyed In

Referenced Out

MONUMENT DETAIL

Previous Renewals M17-34, 1966 DCSG

Monument(s) Found: (Condition and Source)

2 1/2" BRASS CAP ON A 1 1/2" O.D. IRON PIPE PROTRUDING 14" ABOVE GROUND (1966 DCSG)

3/4" I.D. IRON PIPE PROTRUDING 2" ABOVE GROUND IS FOUND ALONG NW'LY EDGE OF R/LIP (M17-34)

COUNTY SURVEYORS OFFICE

T31S R6W

S30	S29
S31	S32

S30	S29
S31	S32

1966

Accessories Found:

- 22" NOW 22" DIA 30' HIGH D.FIR SNAG WITH BARK SCRIBING "S BT" BEARS S60°W, 11.4 FT (REC S60°W 10.6 FT DIST IS TO BARK SCRIBING) ORT
- 15" NOW 36" DIA 2' HIGH D.FIR STUMP WITH BARK SCRIBING "BT" BEARS N66°E, 9.2 FT (REC N66°E 8.6 FT) ORT
- 14" NOW 14" DIA 6' HIGH D.FIR STUMP WITH A GAL. METAL CAP ON TOP AND A FULLY HEALED DOUBLE BLAZE, BEARS S27°E 42.5 FT (AGREES WITH REC) 1966 DCSG
- 42" NOW 39" DIA ~~PIPE~~ WITH A FULLY HEALED DOUBLE BLAZE BEAR S60°W 23.2 FT (REC S60°W 23.9 FT DIST 60% TO CNT OF TRUNK) 1966 DCSG
- 30" NOW 30" DIA DOWN AND OUT OF POSITION D.FIR WE OPENED UPPER BLAZE AND FIND SCRIBING "30 CS" (REC NORTH 15 FT) EVIDENCE OF CAT WORK IN AREA 1966 DCSG

Monument Set (Procedure and Description)

Monument Detail


NONE

N/A

New Accessories

9" DIA PISTOL BUTT D.FIR DOUBLE BLAZED AND SCRIBED
"T315 RGW S31LS BT" BEARS S24°W, 10.6 FT
TO CENTER OF ROOT CROWN.

Sketch of Monument, Accessories, and General Area

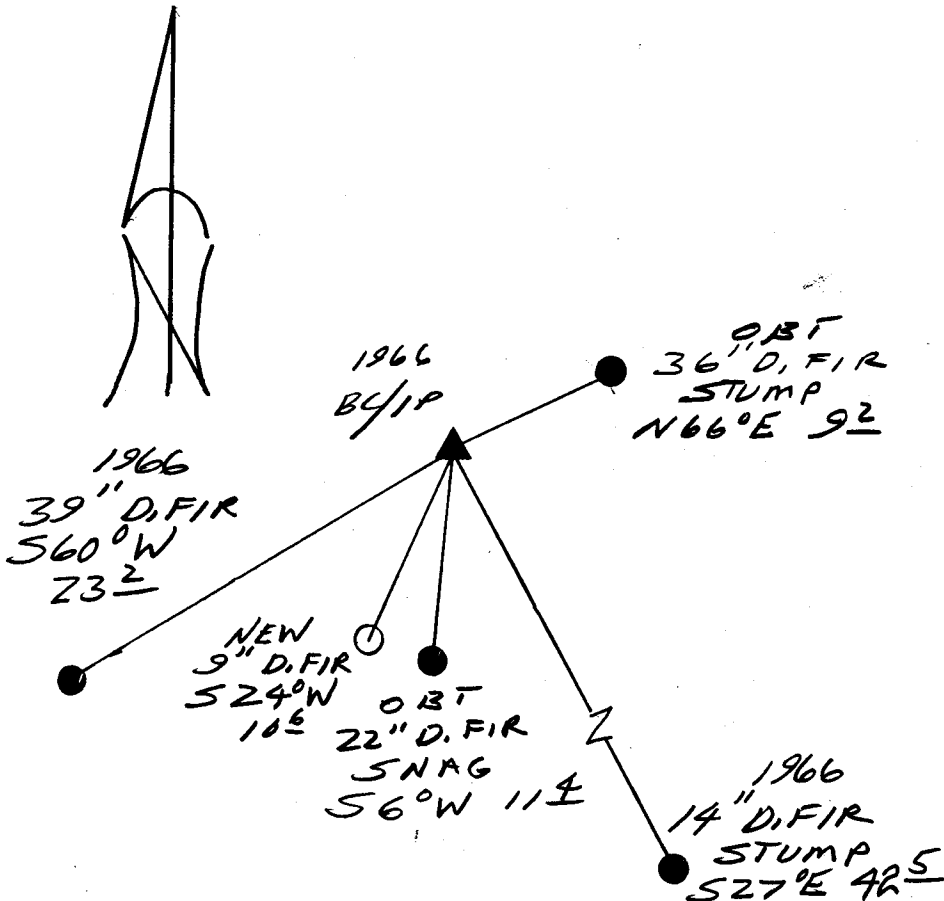

Location & Comments

Comp. Declin. 173/4°E
Agency DCSO
Party Chief RANDALL W SMITH
Notekeeper *[Signature]*
Witnesses STEPHEN J FLAUSE

Address

Surveyor's Seal

REGISTERED
PROFESSIONAL
LAND SURVEYOR

[Signature]
EXPIRES 6-30-98

OREGON
JULY 25, 1980
RANDALL W. SMITH
2469