

GOVERNMENT CORNER RESTORATION FORM

Date: 8.26.96 By: [Signature]

Township 23S Range 9W Sec. 23

County DOUGLAS

This survey consists of:

State OR

Date 5-29-96

No.

Map:

Narrative: Corner Rpt: CS 64/69-20

Corner Designation

1/4 S23 | S24 ?

DOUGLAS COUNTY

- Condition SURVEYOR Only
- Not Found
- Renewed
- Unrecorded
- Surveyed In
- Referenced Out

UNRECORDED RENEWALS

Previous Renewals #74, 1972 HALES, 1967 BLM? 1984 I.P.

MONUMENT DETAIL

Monument(s) Found: (Condition and Source)
ROTTED HUSBAND TACK WITH FLAGGING
(1972 HALES?)

ORIG. STONE NOT FOUND

N/A

Accessories Found:

D. FIR

60" NOW 72" DIA. 3 FT HIGH ROTTED AND BURNT STUMP
NO BLAZING OR SCRIBING FOUND, BEARS N60°E, 33.0 FT
(AGREES WITH 1967 BLM?, ORIG. REC. S60°E, 33.0 FT)
O.B.T.

45" NOW 50" DIA D. FIR TIPPED OUT OF GROUND AND
SLIDE DOWN HILL SHOWS EVIDENCE OF BEING
PREVIOUSLY OPENED POSSIBLY BY OLDS IN REN #74
POSITION UNDETERMINABLE AS ORIG. REC OF
N25°W 37.6 FT FALLS IN A LARGE SLIDE

15" NOW 20" DIA HEMLOCK WITH TAG HEALED INTO
BARK IS FOUND TIPPED OUT OF GROUND, ROOT HOLE
BEARS N.77°W 18.4 FT (AGREES WITH 1984 I.P.)
SOURCE UNKNOWN WEYERHAUSER'S

21" NOW 25" DIA HEMLOCK WITH A PARTIALLY HEALED
SINGLE BLAZE NO SCRIBING VISIBLE, APPEAR'S NOT
TO HAVE BEEN SCRIBED, BEARS N87°W, 9.0 FT
(AGREES WITH I.P. REC). 1984 I.P. TAG

8" NOW 13" DIA HEMLOCK WITH A PARTIALLY HEALED
SINGLE BLAZE NO SCRIBING VISIBLE APPEAR'S NOT
TO HAVE BEEN SCRIBED BEARS S69 3/4°E, 35.5 FT
(AGREES WITH I.P. REC) 1984 I.P. TAG

RENEWAL

Monument Detail

Monument Set (Procedure and Description)

2 7/8" DIA BRASS CAP ON A 1 3/8" O.D.
 BY 32" LONG IRON PIPE IS SET
 AT POSITION OF FOUND H&T, BC/IP
 PROTRUDES 7" ABOVE GROUND

DOUGLAS COUNTY SURVEYORS
 T235


1/4 523/524 R
 9
 W

1996
 OFFICE

New Accessories

25" I.P. HEMLOCK IS SINGLE BLAZED HIGH AND SCRIBED "1/4 523 CS BT"
 BEARS N 8 1/4° W, 9.0 FT.
 13" I.P. HEMLOCK IS SINGLE BLAZED HIGH AND SCRIBED "1/4 524 CS BT"
 BEARS S 69 3/4° E, 35.5 FT
 CHISED 8" "X" IN SAND STONE ROCK OUT CROP BEARS S 9° W, 7.4 FT
 15" DIA. CEDAR DOUBLE-BLAZED AND SCRIBED "1/4 524 CS BT"
 BEARS N 57 1/2° E, 23.7 FT

Sketch of Monument, Accessories, and General Area

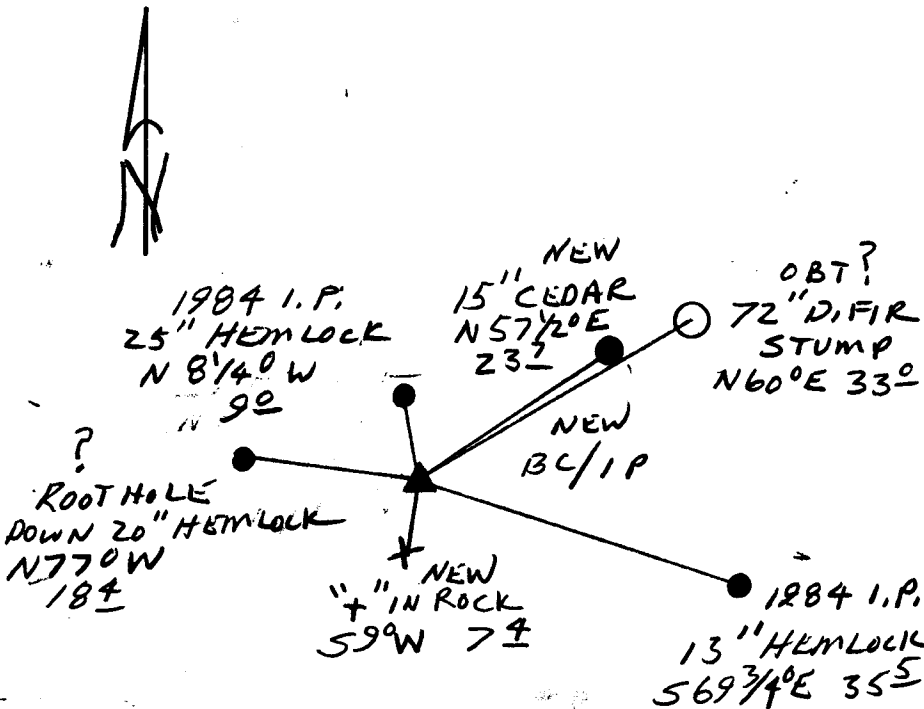

Location & Comments

PERTINATED A POINT
 FROM UNRECORDED
 RENEWAL INFO. OBTAINED
 FROM DAVE FRIEDLEIN

Comp. Declin. 17 3/4° E
 Agency DCSO
 Party Chief RANDALL W. SMITH
 Notekeeper Randall W. Smith
 Witnesses STEPHEN J. FLAUSC

Address

Surveyor's Seal

REGISTERED
 PROFESSIONAL
 LAND SURVEYOR

Randall W. Smith
 EXPIRES 6-30-98

OREGON
 JULY 25, 1990
 RANDALL W. SMITH
 2469