



RENEWAL

Monument Set (Procedure and Description)

NONE


Monument Detail

N/A

New Accessories

6" DIA. MYRTLE DOUBLE BLAZED AND SCRIBED SW DLC 39CS BT BEARS S66°E, 41.7 FT

Sketch of Monument, Accessories, and General Area

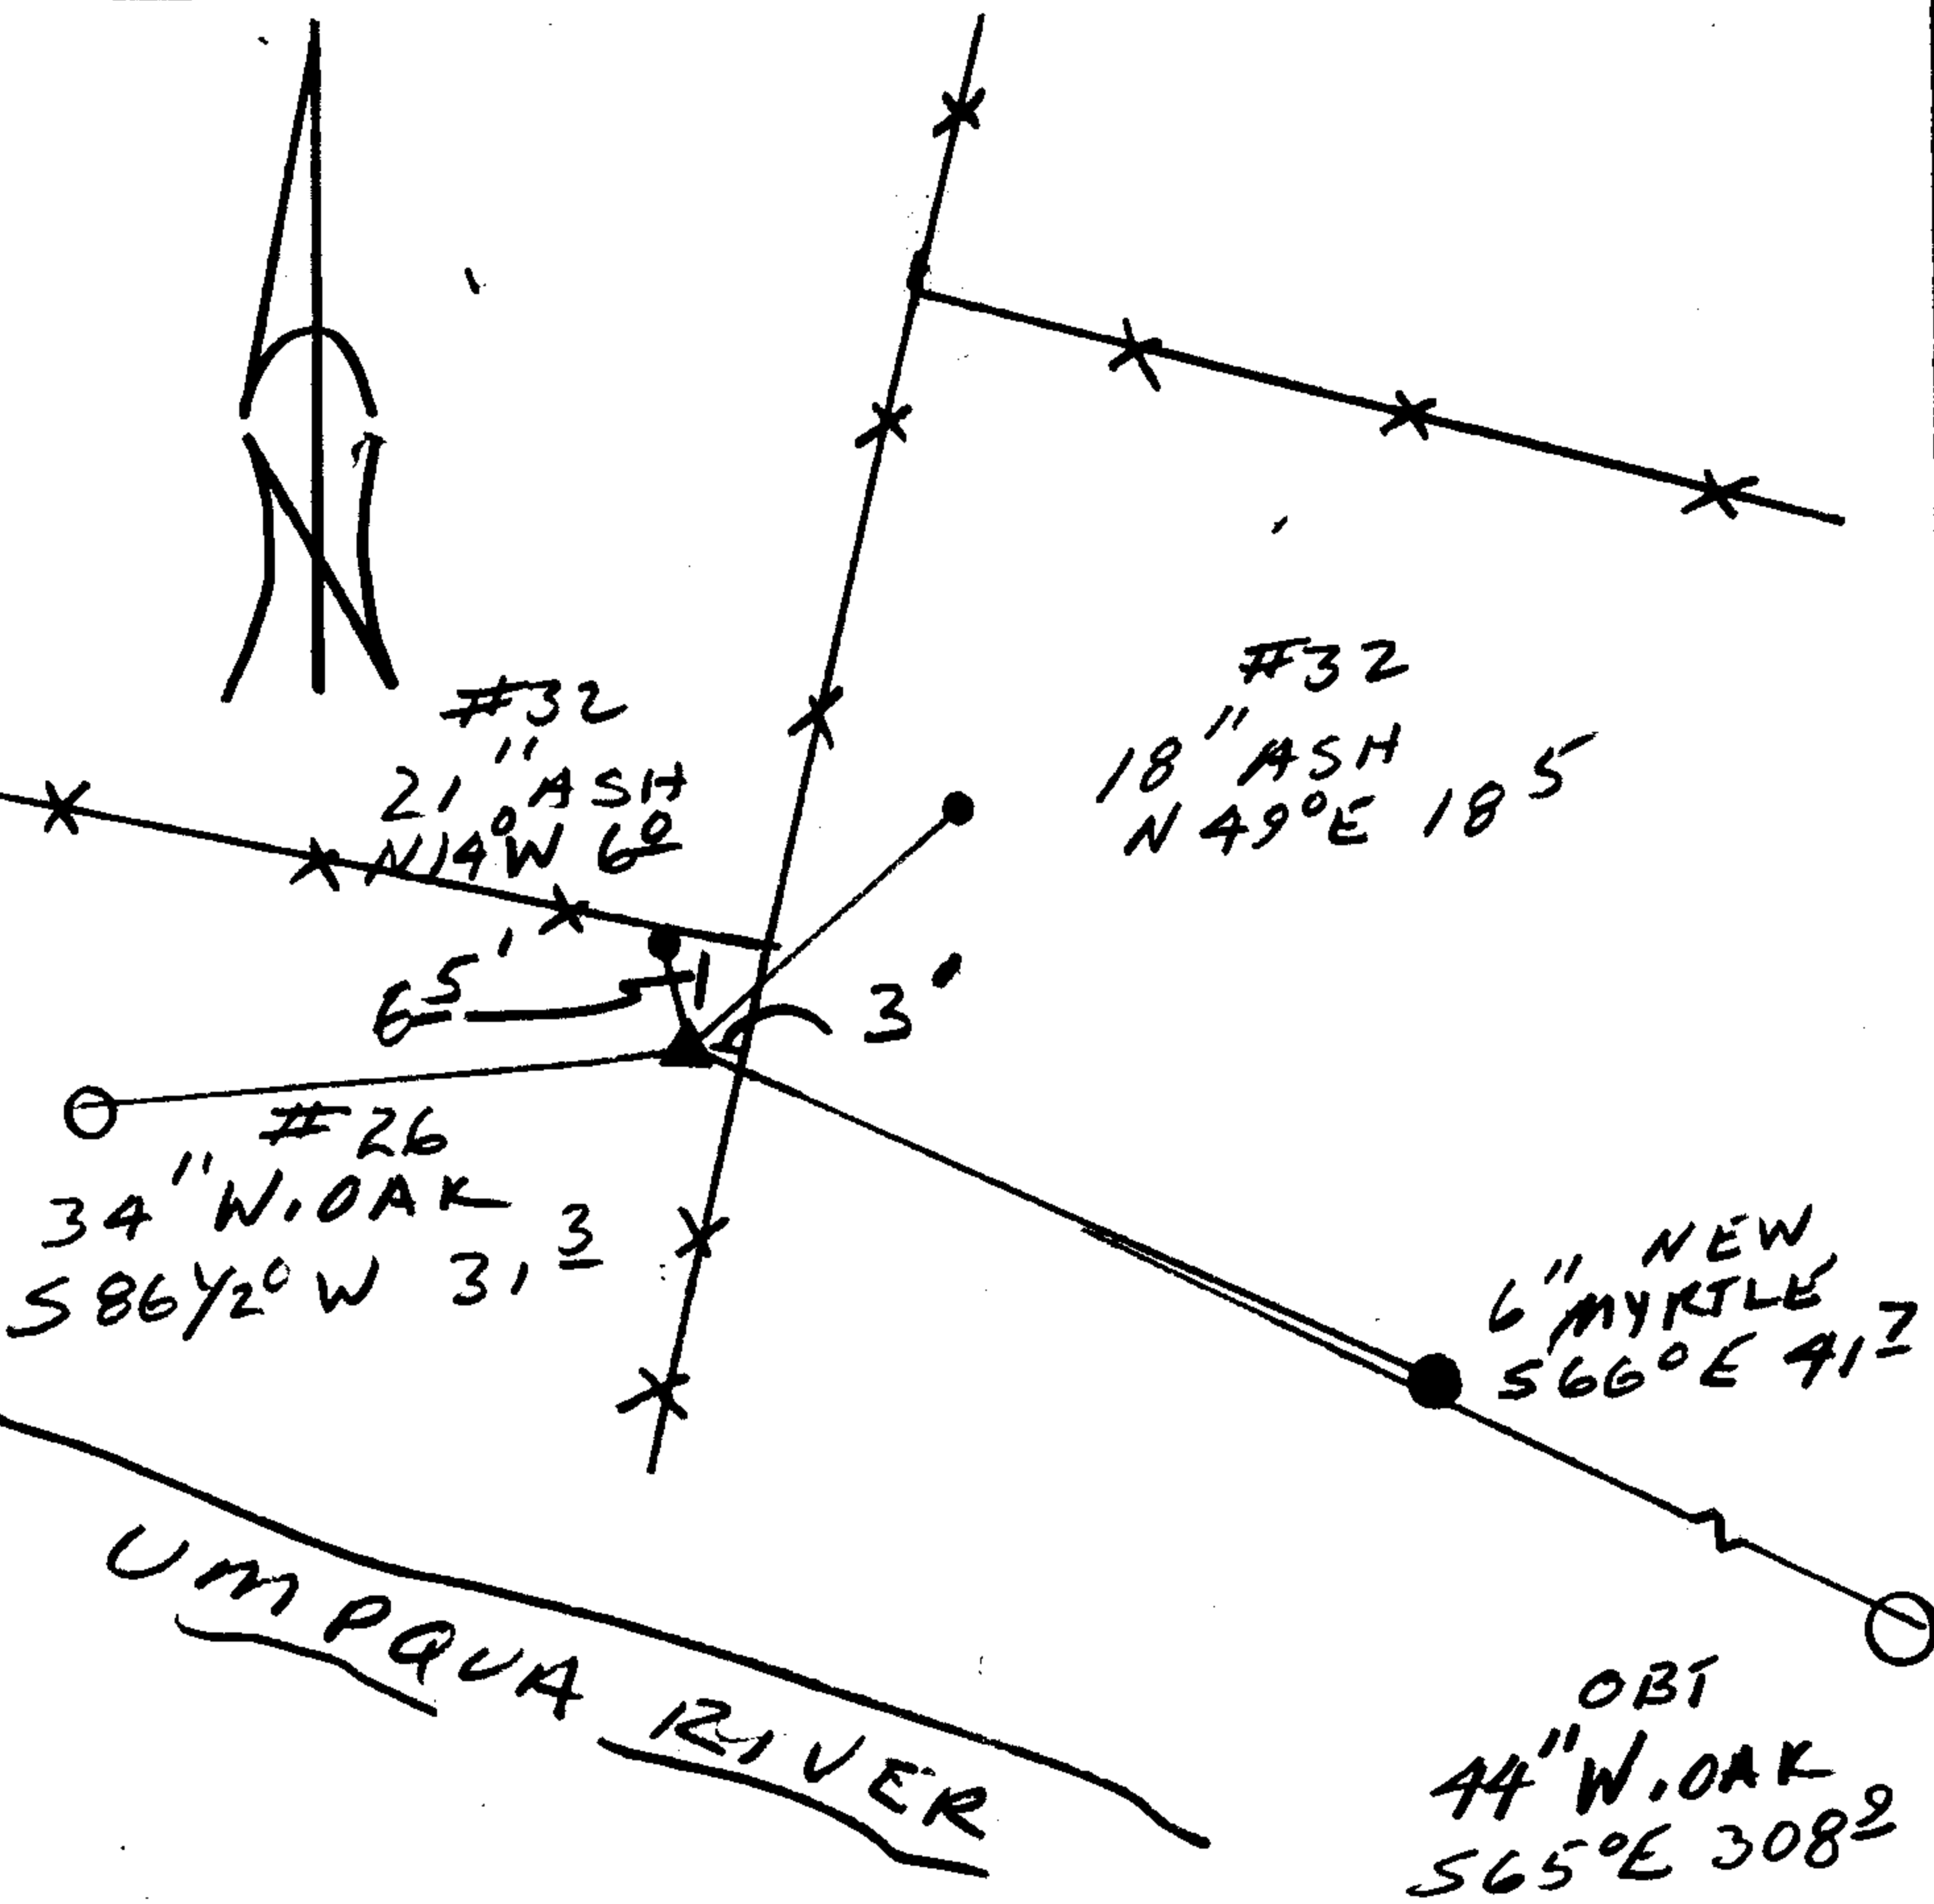

Location & Comments

Comp. Declin.  $17\frac{3}{4}^{\circ} E$   
 Agency DCSO  
 Party Chief RANDALL W SMITH  
 Notekeeper STEVEN J FALSK  
 Witnesses STEVEN J FALSK

Address

Surveyor's Seal

REGISTERED  
 PROFESSIONAL  
 LAND SURVEYOR

Randall W Smith  
 EXPIRES 6-30-98

OREGON  
 JULY 25, 1990  
 RANDALL W. SMITH  
 2469