

RENEWAL

Monument Detail

Monument Set (Procedure and Description)


BC/IP RETURNED TO PLUMP
POSITION NOW PROTRUDES 4"
ABOVE GROUND, SURROUNDED BY A
MOUND OF STONE.

N/A

New Accessories

5/8" I.R. WITH ALUM CAP FOUND 2" BELOW GROUND
BEARS N23°W, 25.6 FT.
POWER POLE "PPL 30-05 207501" BEARS N69°W, 5.2 FT
1" I.D. IRON PIPE PROTRUDING 15" ABOVE GROUND, BEARS
N87 1/2°E, 399.6 FT

Sketch of Monument, Accessories, and General Area

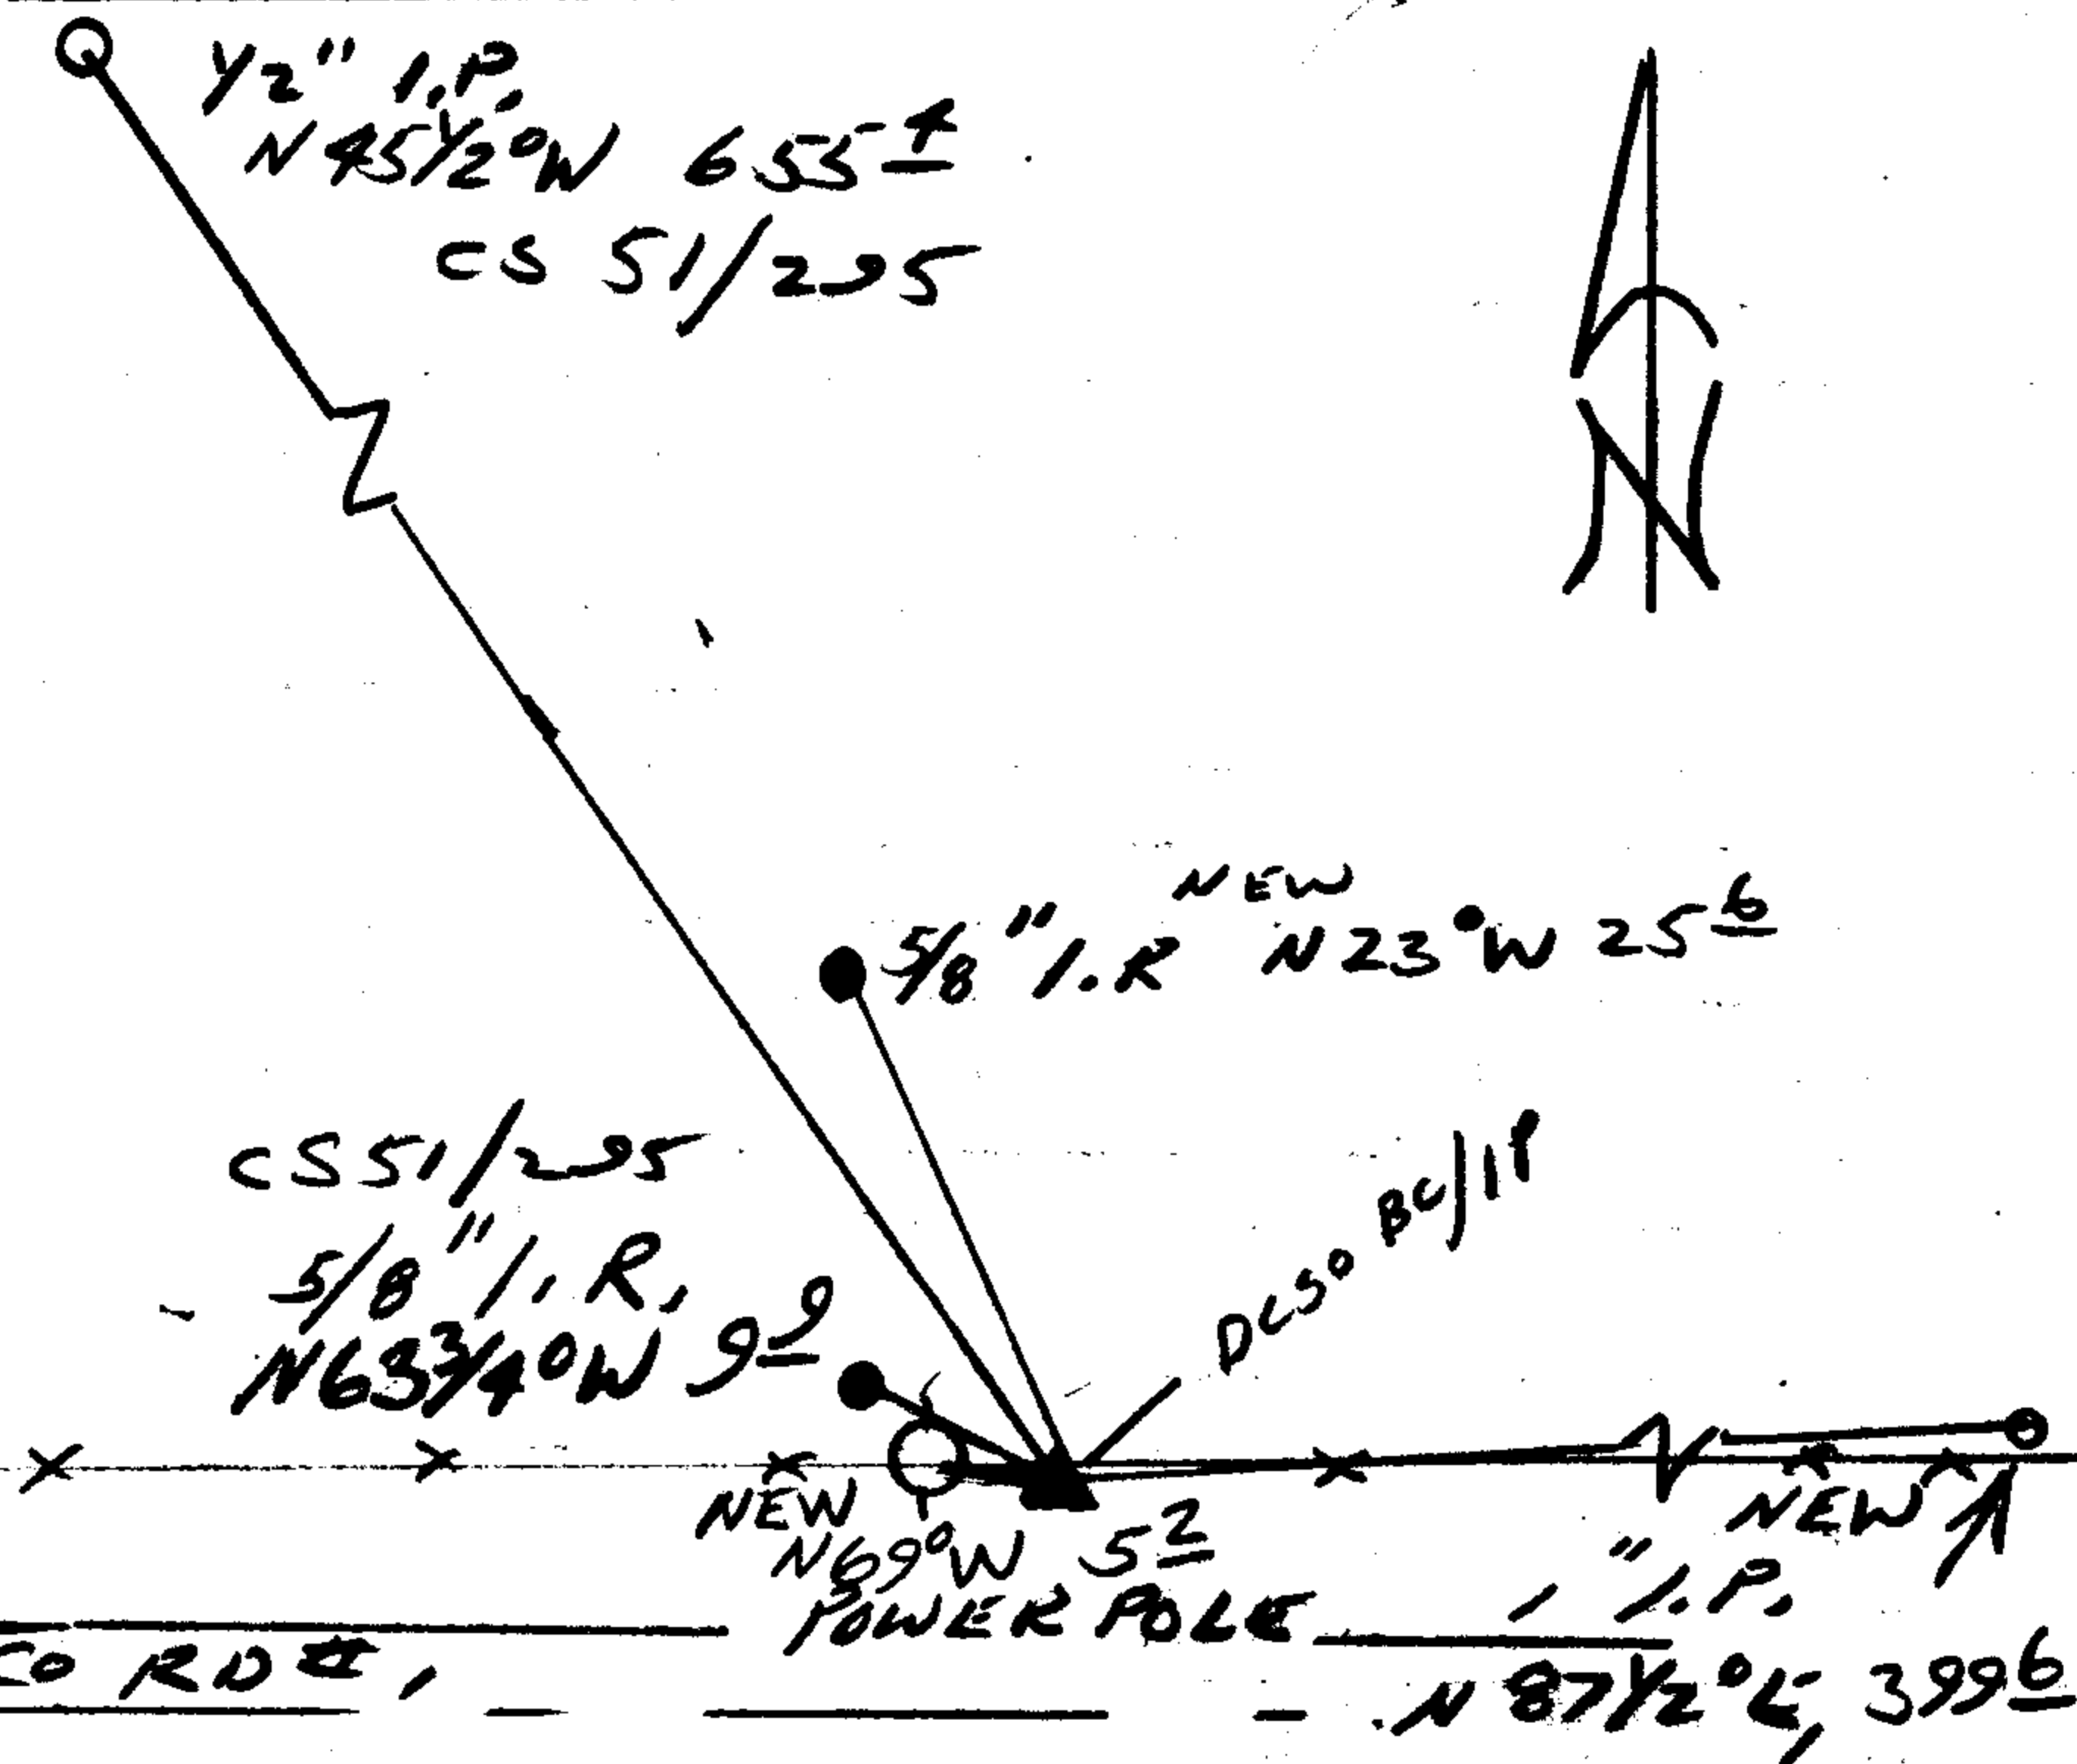

Location & Comments

Comp. Declin. 17 3/4° E
Agency DCSO
Party Chief RANDALL W. SMITH
Notekeeper
Witnesses STEPHEN J. FLAISE

Address

Surveyor's Seal

REGISTERED
PROFESSIONAL
LAND SURVEYOR

Randall W. Smith
EXPIRES 6-30-98

OREGON
JULY 25, 1990
RANDALL W. SMITH
2489