

GOVERNMENT CORNER RESTORATION FORM

DATE: 1-28 BY: 97

Township 27S Range 3W Sec. 27

County DOUGLAS

This survey consists of:


State OR

Date 1-16-97

No.

65 64/71-8

Corner Designation

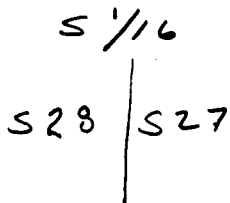

DOUGLAS COUNTY SURVEYOR

- Condition Report Only
- Not Found
- Renewed
- Unrecorded
- Surveyed In
- Referenced Out

Previous Renewals NONE

Monument(s) Found: (Condition and Source)

3/4" BRASS CAP ON A 2 1/2" O.D.  
 IRON PIPE PROTRUDES 4" ABOVE  
 GROUND. ORIG. COR.

U.S. CADASTRAL SURVEY  
S 1/16

S28 | S27

1958

BUREAU OF LAND MANAGEMENT

Accessories Found:

10" NOW 12" DIA. 2 FT HIGH ROTTED D. FIR STUMP  
 WITH SCRIBING "S 1/16 S27", BEARS N 13 1/2° E 17.2 FT  
 BEARS N 13 1/2° E, 17.2 FT (AGREES WITH REC) OBT

8" NOW 14" DIA. DEEP CHINQUAPIN WITH A PARTIALLY  
 HEADED SINGLE BLAZE NO SCRIBING VISIBLE,  
 BEARS S 15° W, 25.1 FT (REC S 13° W, 25.1 FT) OBT

RENEWAL

Monument Set (Procedure and Description)

NONE

Monument Detail

N/A


New Accessories

11" DIA. D. FIR DOUBLE BLAZED AND SCRIBED "S 1/16 S 27 CS B7" BEARS N 5° E, 16.6 FT

7" DIA. HEMLOCK DOUBLE BLAZED AND SCRIBED "S 1/16 S 28 CS B7" BEARS N 59° W, 34.4 FT

10" DIA MADRONE BARK SCRIBED "S 1/16 S 27 CS B7" BEARS N 81° E, 25.0 FT

Sketch of Monument, Accessories, and General Area

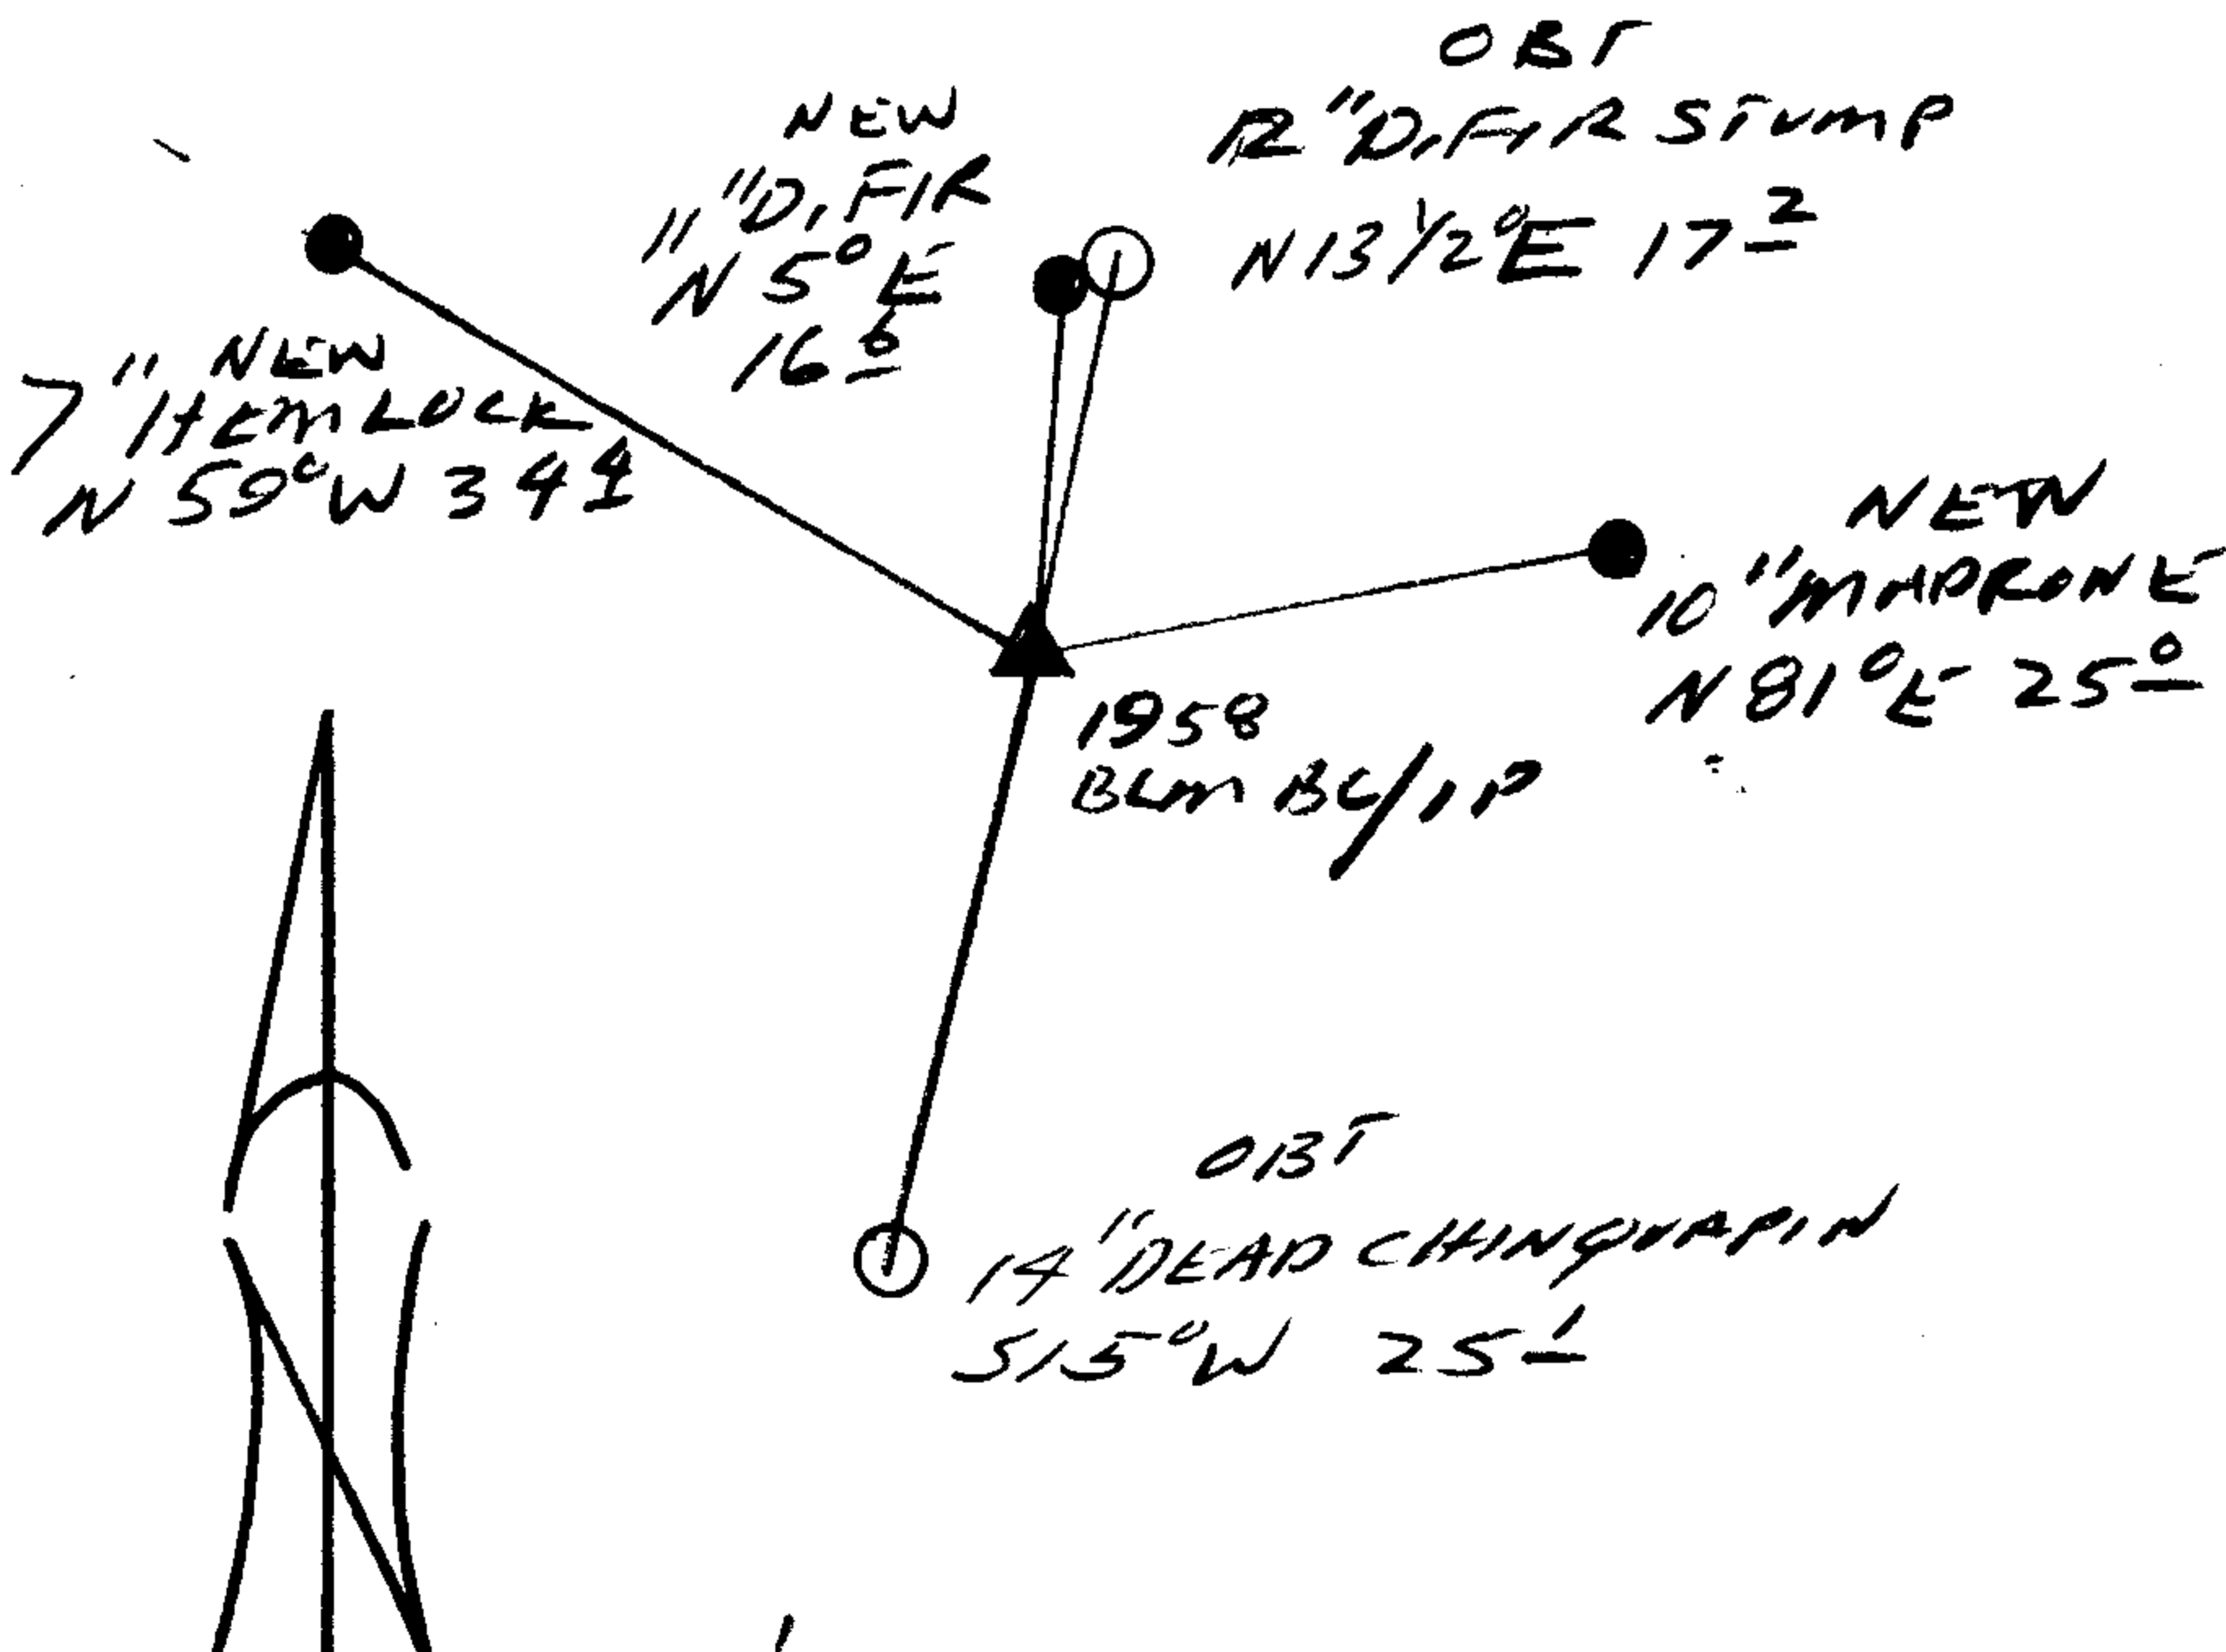

Location & Comments

Comp. Declin. 17 3/4°  
 Agency DCSO  
 Party Chief RANDALL W. SMITH  
 Notekeeper [Signature]  
 Witnesses STEPHEN J. FLAVSE

Address

Surveyor's Seal

REGISTERED  
 PROFESSIONAL  
 LAND SURVEYOR

Randall W. Smith  
EXPIRES 6-30-98

OREGON  
 JULY 25, 1990  
 RANDALL W. SMITH  
 2469