



Monument Set (Procedure and Description)

Monument Detail


NONE

N/A

New Accessories

14" DIA. D. FIR DOUBLE BLAZED AND SCRIBED  
"T28 R3W S2CS BT" BEARS N62°W, 17.3 FT

Sketch of Monument, Accessories, and General Area

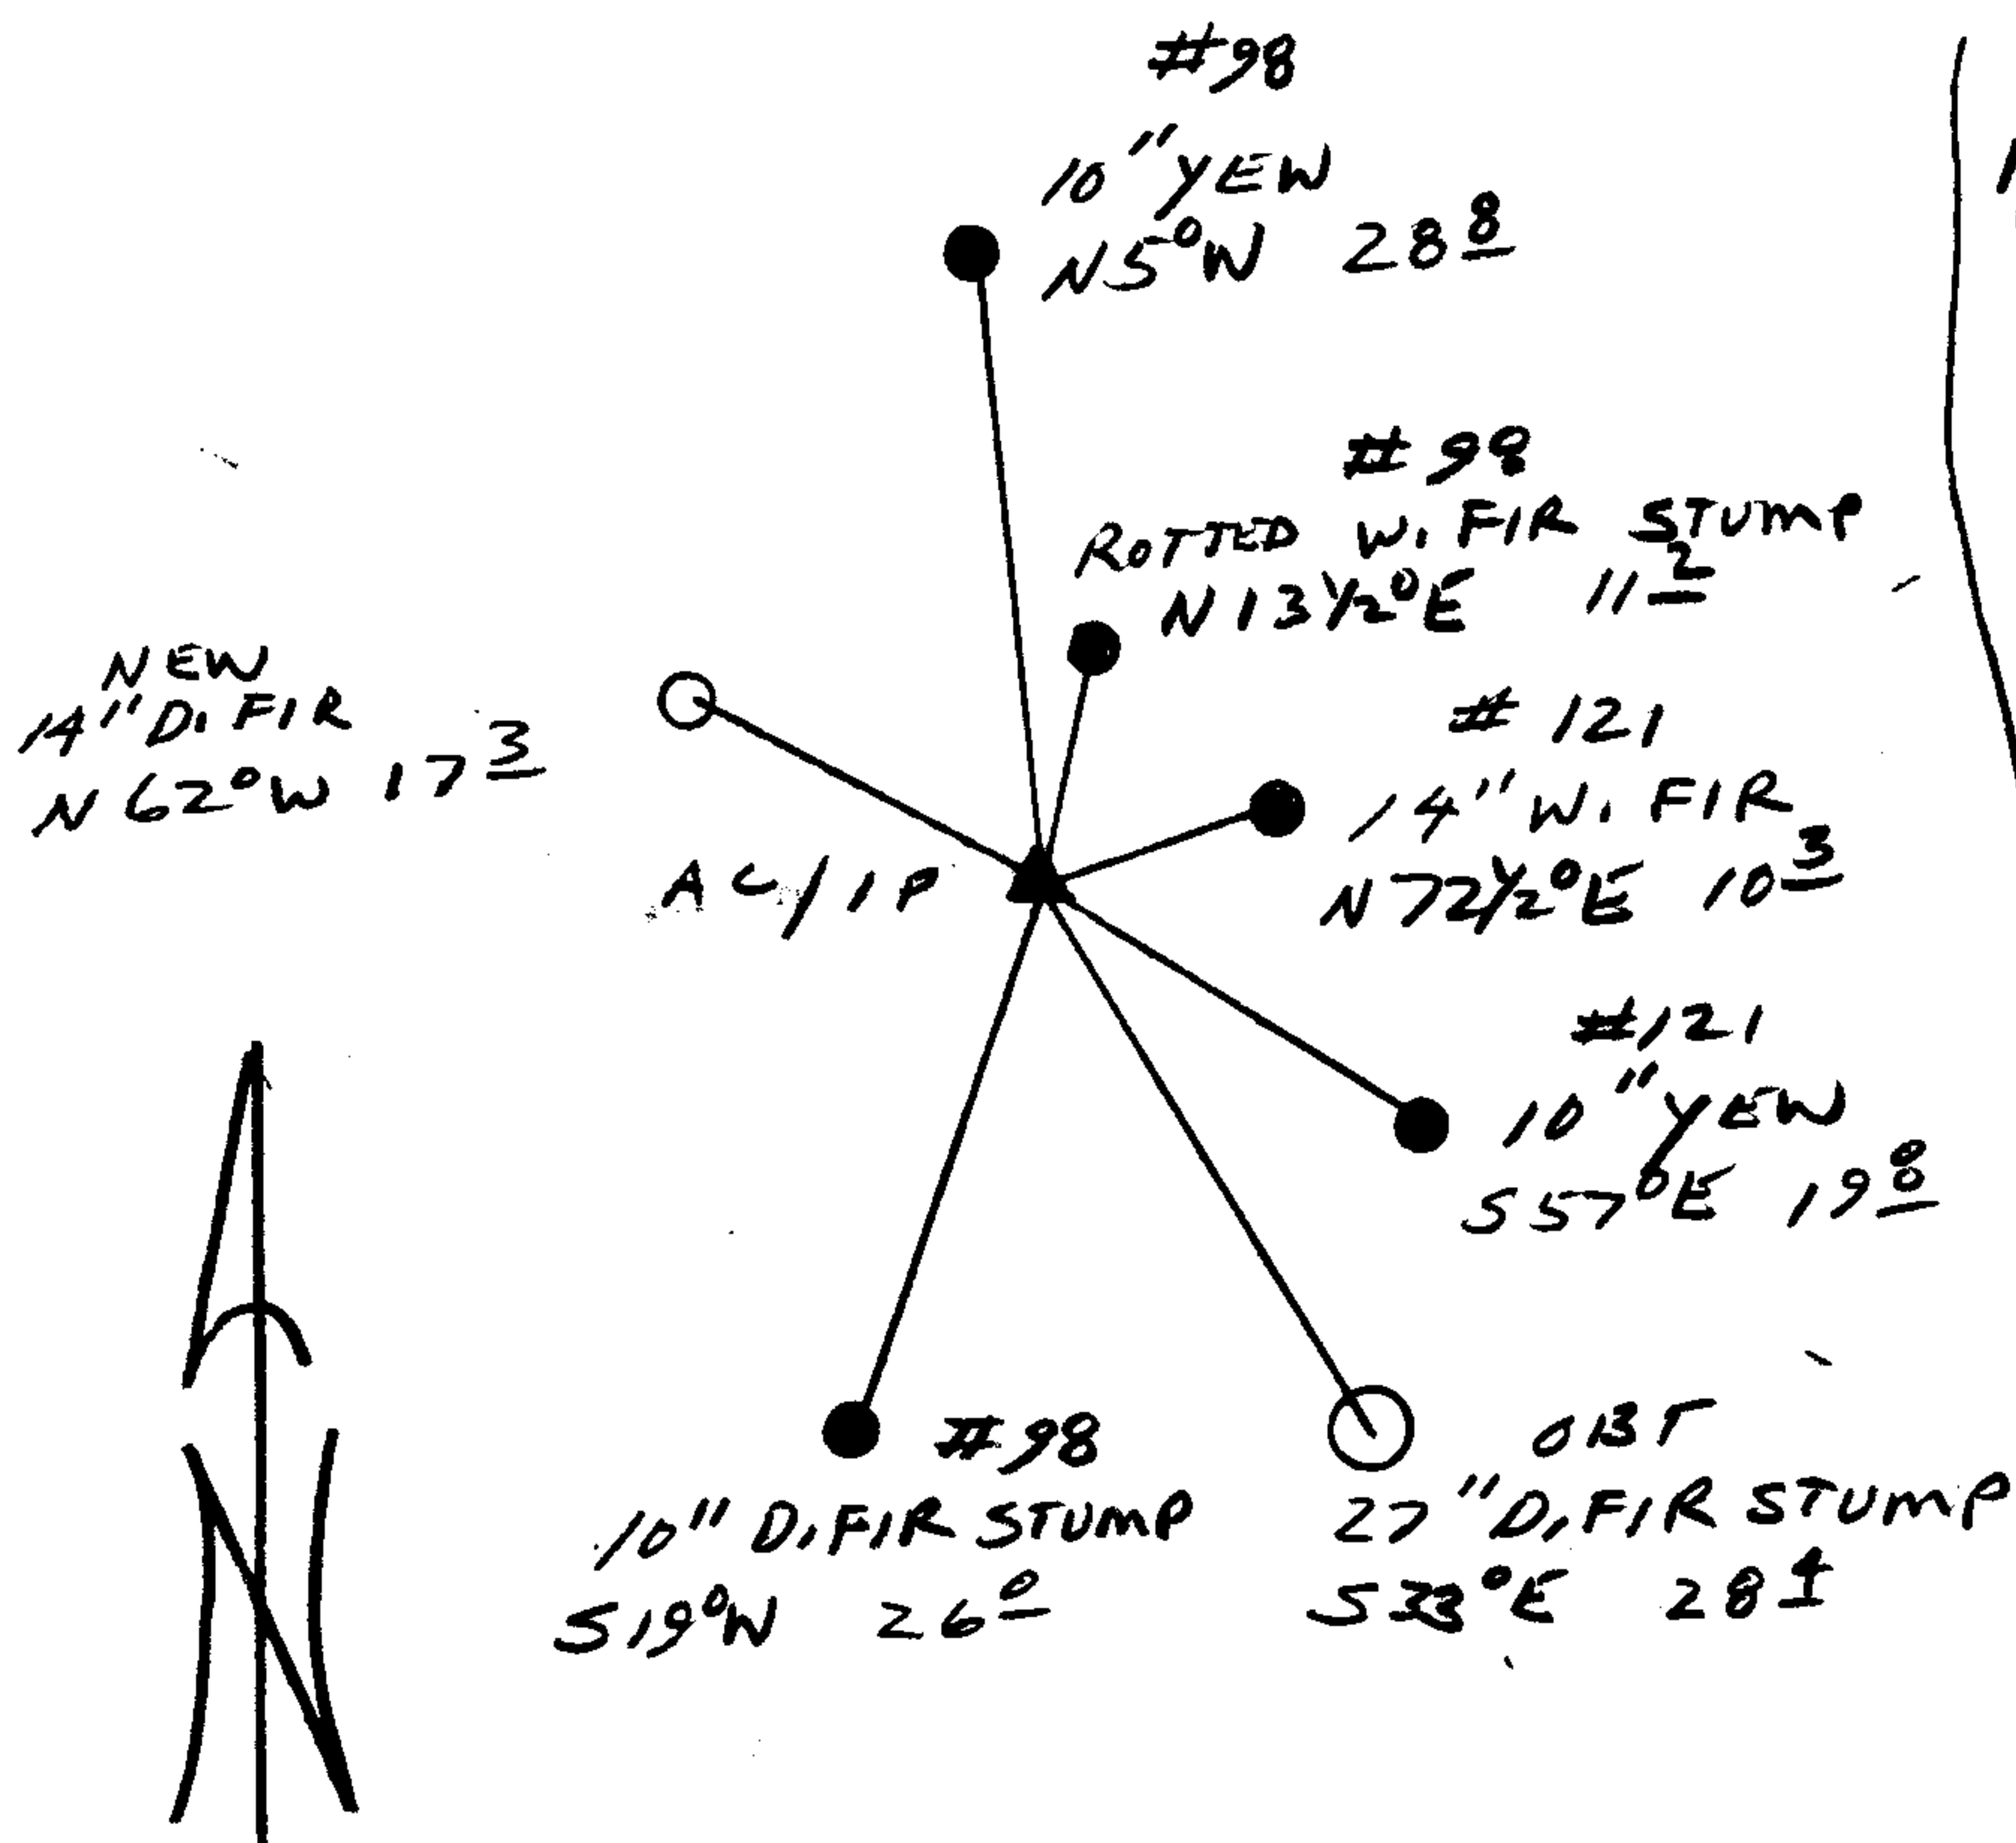

Location & Comments

Comp. Declin. 17 3/4° E  
 Agency DCSG  
 Party Chief RANDALL W. SMITH  
 Notekeeper [Signature]  
 Witnesses STEPHEN J. FLOUSE

Address

Surveyor's Seal

REGISTERED  
PROFESSIONAL  
LAND SURVEYOR

Randall W. Smith  
EXPIRES 6-30-98

OREGON  
JULY 25, 1990  
RANDALL W. SMITH  
2469