

GOVERNMENT CORNER RESTORATION FORM

Date: 3/13/97 By: BC

This survey consists of:

Township 31S Range 5W Sec. 6 County DOUGLAS

Map: \_\_\_\_\_

State OR Date 3-3-97 No. \_\_\_\_\_

Narrative: \_\_\_\_\_

Corner Rpt: CS 64/71-12

Corner Designation

1878

S1 | S6 1/4  
ONLY

PI # 100640

Previous Renewals 1878 GLO, 1979 DCSO, 1980 BLM

Monument(s) Found: (Condition and Source)

NONE

Accessories Found:

NONE NO REMAINING EVIDENCE OF OBT'S  
AREA WAS CLEAR CUT

SEE BLM RENEWAL DCSO RECORD VOL 95 PG 5 17310  
(JUNIOR POINT CONTROLS THE BEARING OF E-W CENTER LINE OF SEC. 6)

DOUGLAS COUNTY  
SURVEYOR

Condition Report Only

Not Found

Renewed

Unrecorded

Surveyed In

Referenced Out

MONUMENT DETAIL

N/A

100640

G.S. File No. 64/71-12

Monument Set (Procedure and Description)

2 3/8" DIA BRASS CAPON A 1 3/8" O.D. BY  
32" LONG IRON PIPE IS SET BY  
COMPASS BEARING AND RECORD  
DISTANCE PER LATASET RECORD  
(1900 BLM N 20 1/4 W 7512 FT)  
FROM ESTABLISHED EAST 1/4 OF  
SEC. 1 T31S R6W ONLY, 1855  
CORNER TREE, NEW BL/IP  
PROTRUS 7" ABOVE GROUND

DOUGLAS COUNTY SURVEYORS  
T31S

R 6 S 1 W | 1/4 S 6 W ONLY R 5 W

1997  
OFFICE


New Accessories

- 22" DIA 2 FT HIGH D.F. FIR STUMP WITH A 6" LONG BOAT SPIKE SET THROUGH A BT TAG NEAR TOP CENTER, B.S. IS STAMPED "B01" B.S. BEARS N 69° E 14.2 FT
- 30" DIA 5 FT HIGH D.F. FIR STUMP WITH A 6" LONG BOAT SPIKE SET THROUGH A BT TAG NEAR TOP CENTER, B.S. IS STAMPED "B02" B.S. BEARS S 58° W 21.6 FT
- 24" DIA 7 FT HIGH D.F. FIR STUMP WITH A 6" LONG BOAT SPIKE SET THROUGH BT TAG NEAR TOP CENTER, B.S. IS STAMPED "B03" B.S. BEARS N 47 1/2° W, 13.7 FT

Sketch of Monument, Accessories, and General Area

Location & Comments

CORNER WAS ON SLOPE WESTERLY SLOPE IN A BURNT CLEAR CUT

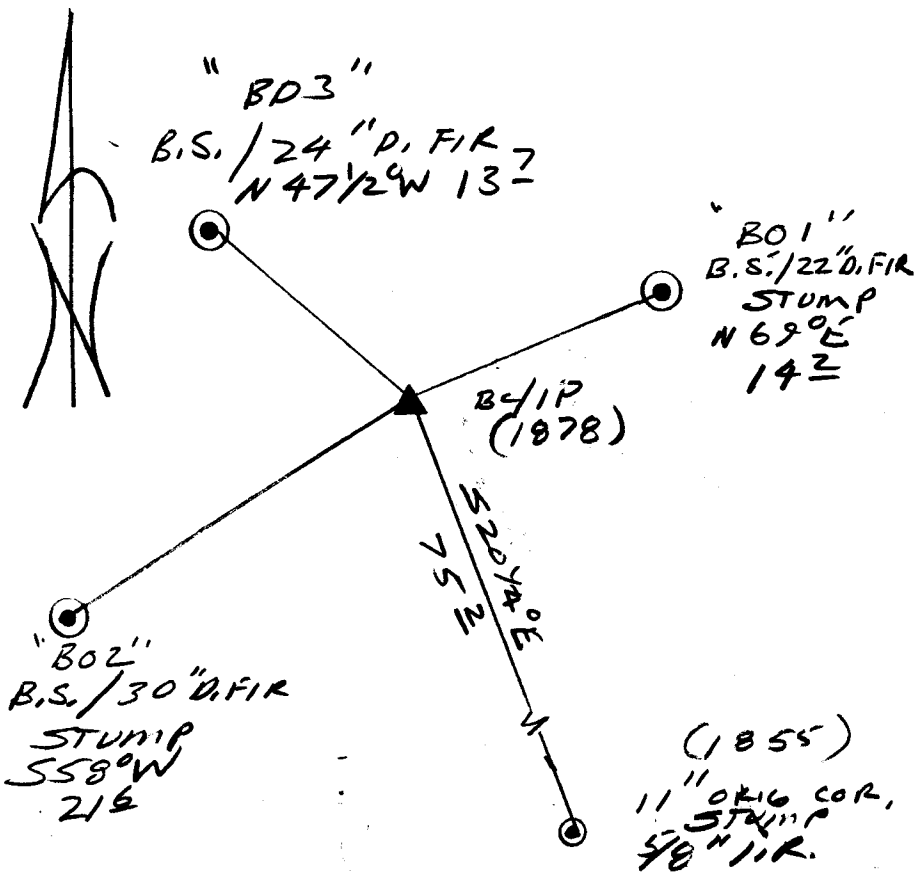

Comp. Declin. 17 3/4° E  
 Agency DCEB  
 Party Chief RANDALL W SMITH  
 Notekeeper [Signature]  
 Witnesses STEPHEN J FLAUSCH

Address

Surveyor's Seal

REGISTERED  
PROFESSIONAL  
LAND SURVEYOR

*Randall W Smith*  
EXPIRES 6-30-98

OREGON  
JULY 25, 1990  
RANDALL W. SMITH  
2469