

Date: 3/13/97 By: PC
This survey consists of:

GOVERNMENT CORNER RESTORATION FORM

Township 27S Range 3W Sec. 27 County DOUGLAS Narrative _____
State OR Date 3-3-97 No. _____ Corner Rpt: 64/71-13

DOUGLAS COUNTY
SURVEYOR

Corner Designation

$\frac{1}{4}$ $\frac{S27}{534}$

- _____ Condition Report Only
- _____ Not Found
- Renewed
- _____ Unrecorded
- _____ Surveyed In
- _____ Referenced Out

MONUMENT DETAIL

Previous Renewals: #83 #160

Monument(s) Found: (Condition and Source)

HURTACK FROM REN #160
NO MONUMENTS FOUND

N/A

Accessories Found:

8" NOW 15" DIA 1 FT HIGH D.F.E.R STUMP WITH A FULLY HEALED BLAZE BEARS S 29° E, 22.4 FT (REL. S 33° E, 22.4 FT) (#83)

11" NOW 20" DIA 1 FT HIGH D.F.E.R STUMP WITH AN OPENED BLAZE SCRIBING VISIBLE "T" BEARS N 65° E, 36.0 FT (AGREES WITH REC.) (#83)

20" DIA 22" HIGH D.F.E.R STUMP WITH PREVIOUSLY OPENED BLAZES SCRIBING VISIBLE "BT" BEARS N 18° W, 14.5 FT ORIG. NW BT NOTED AS DOWN IN 1963/REN #83 MAY HAVE BEEN STOOD UP BY LOGGING, ROOTS ON TOP OF GROUND.

"ORIG. REC N 10° W 11.9 FT"

✓166

RENEWAL

Monument Set (Procedure and Description)

2 3/8" DIA BRASS CAP ON A 1 3/8"
 O.D. BY 32" LONG LEAN PIPE SET AT
 POSITION OF HUB + FACE - BC/IP
 PROTRUDS 6" ABOVE GROUND

Monument Detail

DOUGLAS COUNTY SURVEYORS
 T 275


1/4 527 R
 534 3
 W

1997
 OFFICE

New Accessories

5" DIA PISTOL BUTT D. FIR DOUBLE BLAZED AND SCRIBED "1/4 527 CSBT"
 BEARS N 33° E, 8.5 FT TO CENTER OF PLUMB TRUNK.
 3" DIA D. FIR DOUBLE BLAZED SCRIBED "Y BT" BEARS S 85° W 19.6 FT
 5" DIA. W. FIR DOUBLE BLAZED AND SCRIBED "1/4 527 CSBT"
 BEARS N 58 1/2° W, 42.5 FT
 7" DIA D. FIR DOUBLE BLAZED AND SCRIBED "1/4 534 CSBT"
 BEARS S 27° E, 31.6 FT

Sketch of Monument, Accessories, and General Area

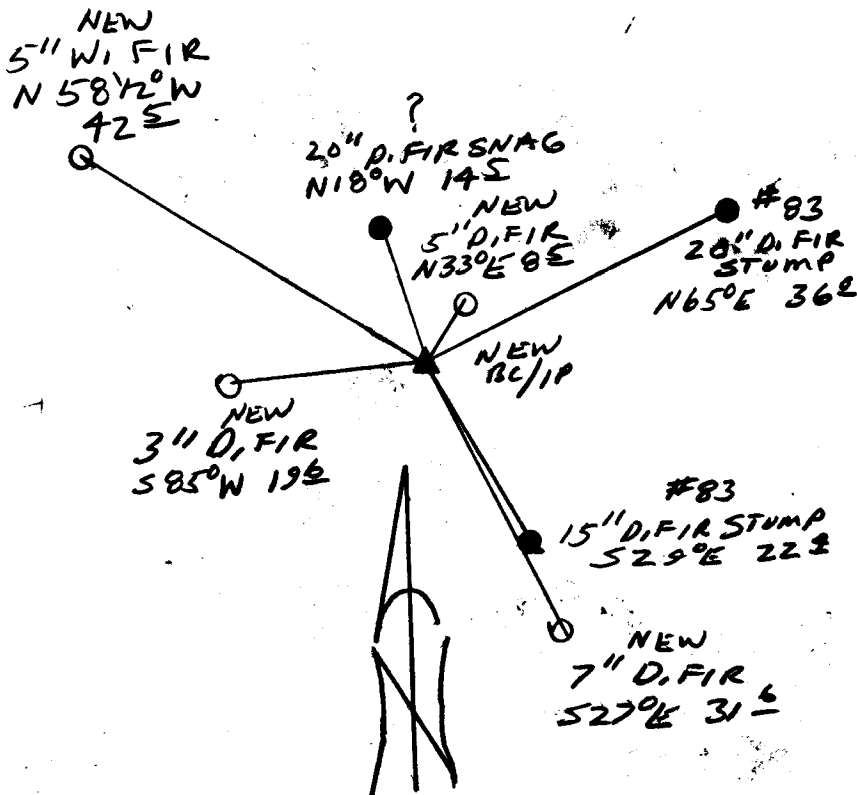

Location & Comments

Comp. Declin. 17 3/4° E
 Agency DCSO
 Party Chief RANDALL W. SMITH
 Notekeeper [Signature]
 Witnesses STEPHEN J. FLANK

Address

Surveyor's Seal

REGISTERED
 PROFESSIONAL
 LAND SURVEYOR

Randall W. Smith
 EXPIRES 6-30-98

OREGON
 JULY 25, 1990
 RANDALL W. SMITH
 2489