

GOVERNMENT CORNER RESTORATION FORM

Date: 3/13/97 By: PC

This survey consists of:

Township 30S Range 5W Sec. 26 County DOUGLAS

State OR Date 3-5-97 No. Narrative:

Corner Apt: CS 64/71-14

Corner Designation

DOUGLAS COUNTY SURVEYOR

- Condition Report Only
- Not Found
- Renewed
- Unrecorded
- Surveyed In
- Referenced Out

NE COR
DLC
62

1873 1940 062010

Previous Renewals VO pg 116, M3-80, 1999 MARKHAM

MONUMENT DETAIL

Monument(s) Found: (Condition and Source)

1/2" I.R. SET IN A 1/2" I.P.
 IRON PIPE. TOP OF I.R. 9"
 BELOW ROAD SURFACE. I.P.
 5" BELOW TOP OF I.R.
 (SOURCE OF I.P. UNKNOWN I.R.
 SET BY FRED HOOPER, PROPERTY
 OWNER)

(M 84-45 REPORT)

N/A

Accessories Found:

11" NOW 26" DIA. W. OAK WITH A FULLY HEALED
 SINGLE BLAZE, BEARS S 92° W, 35.6 FT
 (AGREES WITH 'M 84-45) 1999 MARKHAM

19" NOW 36" DIA. W. OAK WITH A FULLY HEALED
 DOUBLE BLAZE, BEARS N 6° E, 19.1 FT (AGREES
 WITH 1999 RECORD) 1999 MARKHAM

5/8" I.R. IS FOUND 9" BELOW ROAD SURFACE
 BEARS S 93° W, 5.64 FT (REC. S 92° 43' W 5.64 FT)
 M 84-45

1/4" IRON ROD FOUND 6" BELOW ROAD SURFACE
 BEARS N 43° E, 13.07 FT (REC. N 47° 43' E 13.07 FT
 PER M 84-45) SET BY FRED HOOPER PROPERTY OWNER
 APPROX 25 YEARS AGO

Monument Set (Procedure and Description)

Monument Detail


NONE

N/A

New Accessories

NONE

Sketch of Monument, Accessories, and General Area

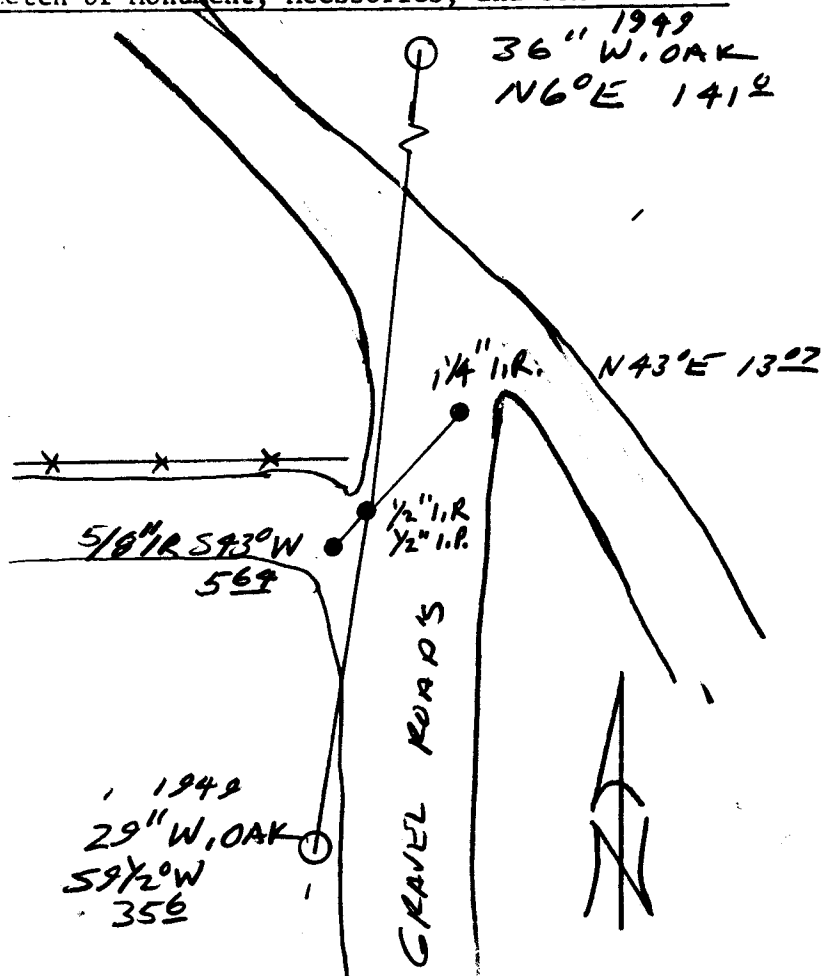

Location & Comments

TALKED WITH PROPERTY OWNER IN AREA FRED HOOPER, SAID HE HAD SET 1/2\"/>

Comp. Declin. 17 3/4° E
Agency ILSO
Party Chief RANDALL W. SMITH
Notekeeper [Signature]
Witnesses STEPHEN J. FRAUSE

Address

Surveyor's Seal

REGISTERED
PROFESSIONAL
LAND SURVEYOR

Randall W. Smith
EXPIRES 6-30-98

OREGON
JULY 25, 1990
RANDALL W. SMITH
2469