

GOVERNMENT CORNER RESTORATION FORM

Date: 3/13/97 By: JC

This survey consists of:

Township 30S Range 4W Sec. 28 County DOUGLAS

Map: _____

State OK Date 3-6-97

No. _____ Narrative: _____

Corner Rpt: CS 64/71-15

Corner Designation

1/4 S29/S28

DOUGLAS COUNTY

- Condition Report Only
- Not Found
- Renewed
- Unrecorded
- Surveyed In
- Referenced Out

MONUMENT DETAIL

Previous Renewals 1949 MARKHAM, 1963 DCSO

Monument(s) Found: (Condition and Source)

BADLY RUSTED 3/4" I.D. IRON
PIPE/ PROTRUDING 4" ABOVE GROUND.
SOURCE UNKNOWN

N/A

Accessories Found:

29" NOW 30" DIA 30 FT HIGH D. FIR SNAG WITH A PARTIALLY
HEALED PREVIOUSLY OPENED BLAZE, BEARS S84°W,
35.0 FT (AGREES WITH REC.) 0 BT.

18" NOW 26" DIA D. FIR WITH BARK SCRIBING VISIBLE
" 1/4 2000" FACING CORNER AND " S BT" FACING
WEST, BEARS S10°W, 38.0 FT (AGREES WITH REC)
1949 MARKHAM

5" NOW 17" DIA D. FIR WITH A FULLY HEALED SINGLE
BLAZE, BEARS N2°E, 23.7 FT (AGREES WITH REC)
1963 DCSO

RENEWAL

Monument Set (Procedure and Description)

2 3/8" DIA BRASS CAP ON A 1 3/8"
 BY 32" LONG IRON PIPE IS
 SET AT REFERENCED POSITION
 OF 3/4" I.P. 3/4" I.P. MEASURED
 24" LONG IS SET ALONG NORTH
 EDGE OF 2" I.P. PROTRUS 4"
 ABOVE GROUND. 3/4" I.P. PROTRUS 6"
 ABOVE GROUND.

Monument Detail


DOUGLAS COUNTY SURVEYORS OFFICE
 T30S R4W
 1/4
 S29 + S28
 1997

New Accessories

11" DIA D. FIR DOUBLE BLAZE AND SCRIBED "1/4 S29 CS BT"
 BEARS N 49 1/2° W, 8.8 FT

6" DIA D. FIR DOUBLE BLAZE AND SCRIBED "1/4 S28 CS BT"
 BEARS S 71 1/2° E, 11.1 FT

Sketch of Monument, Accessories, and General Area

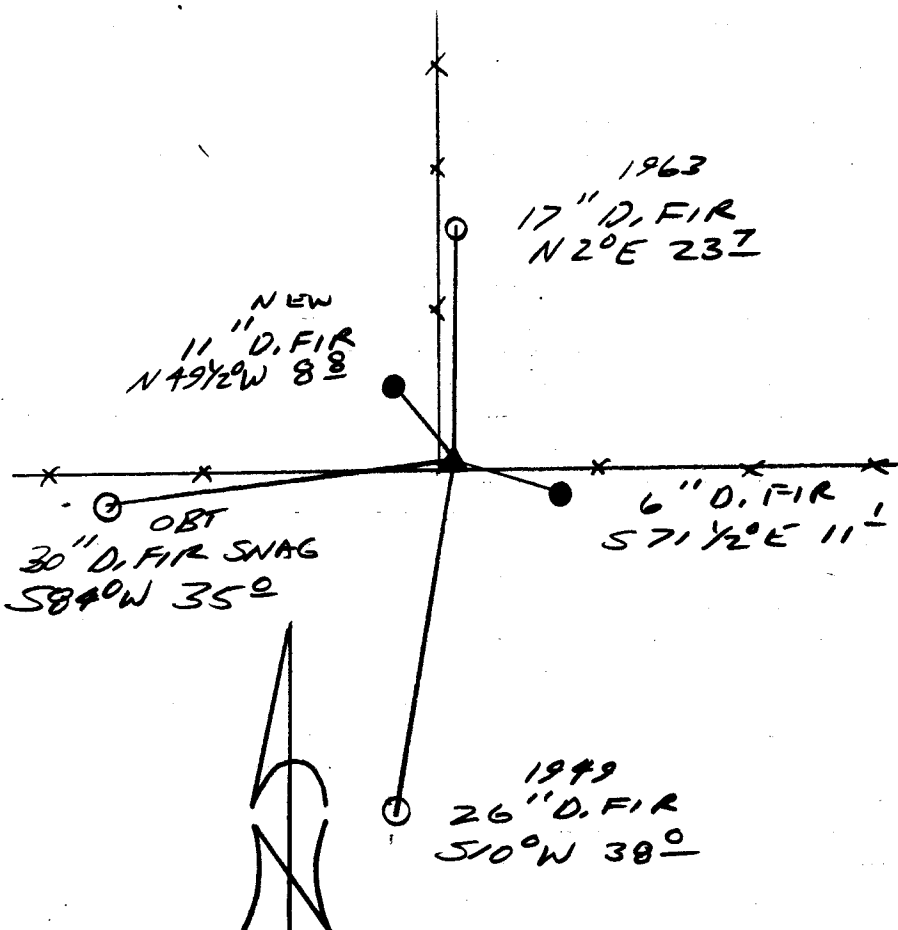

Location & Comments

CORNER LIES AT THE
 INTERSECTION OF DOWN
 FENCE LINES RUNNING
 EAST WEST AND NORTH
 ON A STEEP NORTHERLY
 SLOPE.

Comp. Declin. 17 3/4° E
 Agency DCSC
 Party Chief RANALL W SMITH
 Notekeeper [Signature]
 Witnesses STEPHEN FLAVER

Address

Surveyor's Seal
 REGISTERED
 PROFESSIONAL
 LAND SURVEYOR
 [Signature]
 EXPIRES 6-30-98
 OREGON
 JULY 25, 1990
 RANDALL W. SMITH
 2469