



Monument Set (Procedure and Description)

Monument Detail

NONE


N/A

New Accessories

8" DIA MADRONE BARK SCRIBED "SW D/LC 37 CS BT"  
BEARS S10°W, 12.9 FT.

7" DIA D. FIR DOUBLE BLAZED AND SCRIBED "SW D/LC 37 CS BT"  
BEARS N48°W, 11.9 FT.

Sketch of Monument, Accessories, and General Area

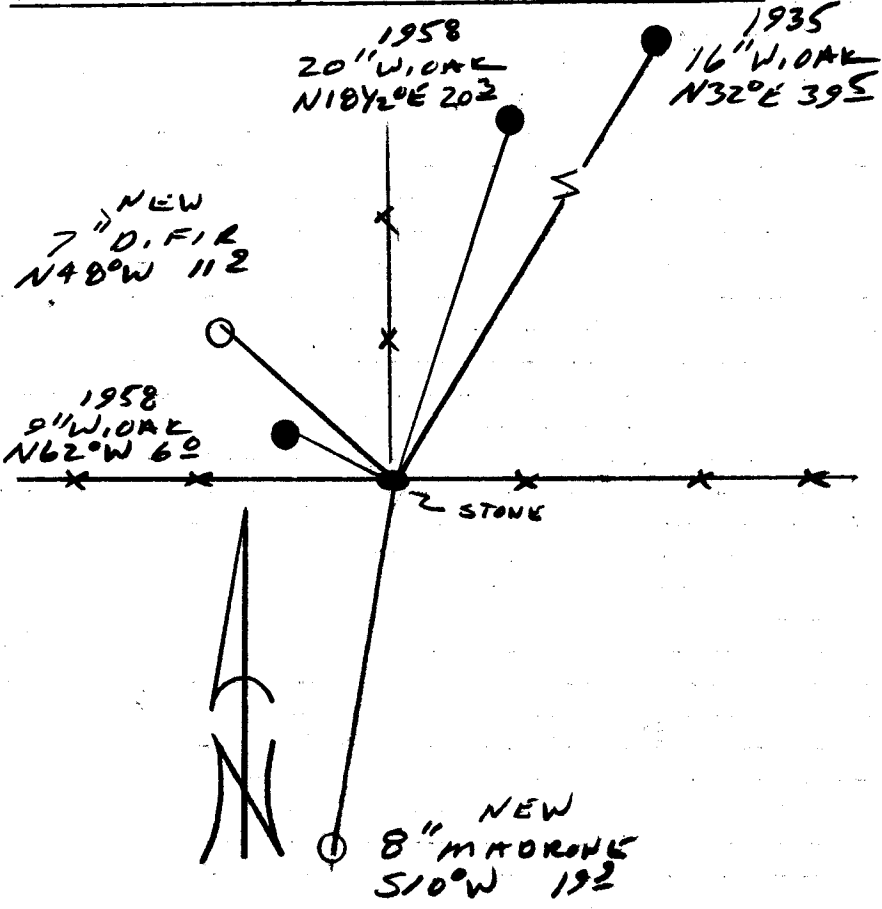

Location & Comments

CORNER IS AT THE INTERSECTION OF OLD DOWN FENCE LINES RUNNING EAST - WEST AND NORTH

Comp. Declin. 17 3/4° E  
Agency DESO  
Party Chief RANDALL W. SMITH  
Notekeeper [Signature]  
Witnesses STEPHEN J. FINE

Address

Surveyor's Seal

REGISTERED PROFESSIONAL LAND SURVEYOR

*Randall W. Smith*  
EXPIRES 6-30-98

OREGON  
JULY 25, 1990  
RANDALL W. SMITH  
2469