

GOVERNMENT CORNER RESTORATION FORM

Date: 3/31/1997 By: 3C

This survey consists of:

Township T2S Range 8W Sec. 32 County DOUGLAS Map: _____
State OR Date 3-13-97 No. _____ Narrative: _____
Corner Post: 64/71-20

Corner Designation

S 32 | S 33
S 4

PI # 314700

Previous Renewals 1945 + 1965 BLM

Monument(s) Found: (Condition and Source)
2 1/2" DIA BRASS CAP ON A 2" O.D.
IRON PIPE PROTRUDES 12" ABOVE
GROUND. (1945)

- DOUGLAS COUNTY
SURVEYOR
- Condition Report Only
 - Not Found
 - Renewed
 - Unrecorded
 - Surveyed In
 - Referenced Out

MONUMENT DETAIL

U.S. GENERAL LAND OFFICE SURVEY

T21S R8W
S 32 | S 33
T22S R8W
S 4
1945

Accessories Found:

NO OBJECTS FOUND

36" DIA NOW 38" DIA DOWN D.FIR BEARS
N 45 1/2° E, 35.0 FT (AGREED WITH 1965 RENEWAL) 1995

6" NOW 18" DIA 2 1/2' HIGH CEDAR STUMP WITH A
HEALED BLAZE, BEARS N 70° W 36.3 FT (AGREED
WITH 1965 RENEWAL) 1995

23" NOW 30" DIA D.FIR WITH A FULLY HEALED
SINGLE BLAZE, BEARS N 53° E, 43.6 FT (REC.
N 47° E, 43.6 FT POSSIBLE COMPASS READING ERROR)
1965

Monument Set (Procedure and Description)

Monument Detail

N/A

N/A


New Accessories

20" DIA W. FIR DOUBLE BLAZED AND SCRIBED "T21S R8W S32 CS BT"
BEARS N47°W, 17.6 FT

10" DIA MAPLE DOUBLE BLAZED AND SCRIBED "T21S R8W S33 CS BT"
BEARS N60°E, 20.2 FT

16" DIA W. FIR - DOUBLE BLAZED AND SCRIBED "T21S R8W S33 CS BT"
BEARS N80°E 69.3 FT

Sketch of Monument, Accessories, and General Area

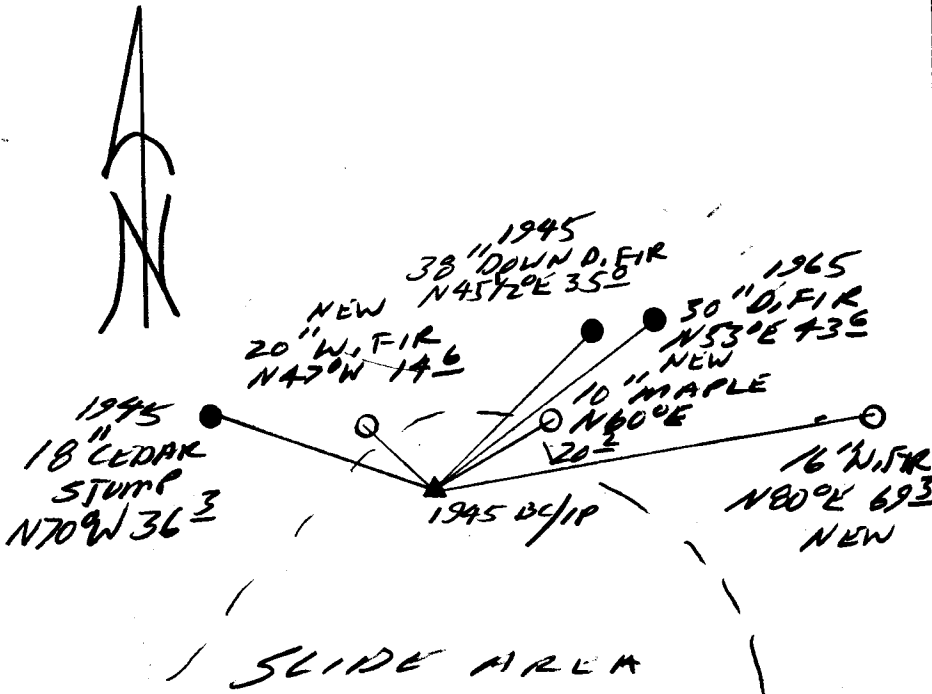

Location & Comments

CORNER LIES ON A STEEP
SOUTHERLY SLOPE IN A
SLIDE AREA

Comp. Declin. 17 3/4° E
Agency DLSO
Party Chief RANDALL W. SMITH
Notekeeper
Witnesses STEPHEN J. FLAISE

Address

Surveyor's Seal

REGISTERED
PROFESSIONAL
LAND SURVEYOR

RANDALL W. SMITH
EXPIRES 6-30-98

OREGON
JULY 25, 1980
RANDALL W. SMITH
2489