

GOVERNMENT CORNER RESTORATION FORM

Date: 3/31/1997 By: PC

This survey consists of:

Township R1S Range 8W Sec. 33 County DOUGLAS Map: \_\_\_\_\_

State OR Date 3-13-97 No. \_\_\_\_\_

Narrative: \_\_\_\_\_

Corner Ref: 64/71-21

Corner Designation

1/4 SEC 33 ONLY

DOUGLAS COUNTY

Condition Report  Only

Not Found

Renewed

Unrecorded

Surveyed In

Referenced Out

MONUMENT DETAIL

Previous Renewals 1945 GLO

Monument(s) Found: (Condition and Source)

2 1/2" DIA BRASS CAP ON A  
1" O.D. IRON PIPE PROTRUDS  
2" ABOVE GROUND. (1945)

U.S. GENERAL LAND OFFICE

Y4S33

1945  
SURVEY

Accessories Found:

20" NOW 62" DIA. D. FIR WITH A HEALED DOUBLE BLAZE,  
BEARS N80°W, 160.5 (REC. N90°W 158.4 FT  
DIST IS A GOOD FACE MEASUREMENT) 0BT

16" NOW 28" DIA. D. FIR WITH A HEALED DOUBLE BLAZE,  
BEARS N65 1/4°W, 170.9 FT (AGREES 1945 REC) 1945

Monument Set (Procedure and Description)

Monument Detail

NONE

N/A


New Accessories

14" DIA. D. FIR DOUBLE BLAZED AND SCRIBED "Y4533CS BT"  
BEARS N 72 1/2° E, 13.0 FT.

21" DIA. D. FIR DOUBLE BLAZED AND SCRIBED "Y4533CS BT"  
BEARS N 16° W, 5.2 FT.

Sketch of Monument, Accessories, and General Area

Location & Comments

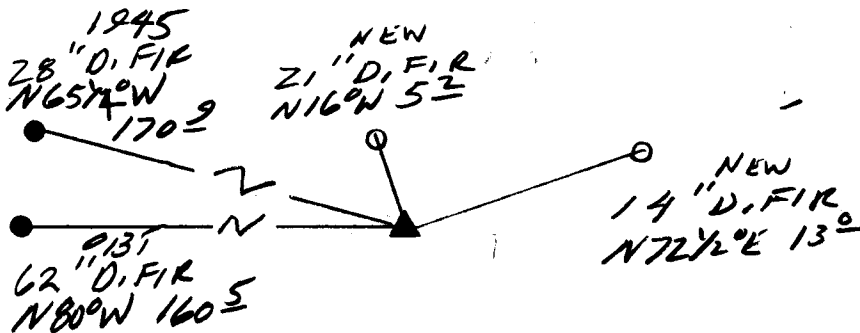

Comp. Declin. 17 3/4° E  
 Agency DLSO  
 Party Chief RANDALL W. SMITH  
 Notekeeper [Signature]  
 Witnesses STEPHEN J. FAUSE

Address

Surveyor's Seal

REGISTERED  
 PROFESSIONAL  
 LAND SURVEYOR

[Signature]  
FAUSE 670-28

OREGON  
 JULY 25, 1990  
 RANDALL W. SMITH  
 2469