

GOVERNMENT CORNER RESTORATION FORM

Date: 8-8-97 By: PC

Township 255 Range SW Sec. 1

County DOUGLAS

This survey consists of:

State OR

Date 7-29-97

No. \_\_\_\_\_

Corner CS 64/71-26

Corner Designation \_\_\_\_\_

S 2 | S 1  
-----  
S 11 | S 12

- Only
- Not Found
- Renewed
- Unrecorded
- Surveyed In
- Referenced Out

PI # 600600

Previous Renewals 1934, 1960 + 1977 DCSO

Monument(s) Found: (Condition and Source)

2 1/2" BRASS CAP ON A 1 1/2" O.D. IRON PIPE, PROTRUS 10" ABOVE GROUND. (1960 DCSO)

COUNTY SURVEYORS OFFICE  
T255 R5W

S 2 | S 1  
-----  
S 11 | S 12  
1960

Accessories Found:

15" Y. OAK NOW ROOT HOLE REC " S75°E 3.3 FT "OBT (AGREES WITH REC.)

20" Y. OAK NOW ROOT HOLE REC " S17 1/2°W, 60.7 FT "OBT (AGREES WITH REC.)

10" NOW DOWN AND ROTTEN OAK NO DESCRIBING VISIBLE ROOT HOLE BEARS N16°W, 27.9 FT (AGREES WITH REC.) 1934

10" NOW 12" DIA. DEAD MADRENE WITH A PREVIOUSLY OPENED UNHEALED AXE WOUND, BEARS N38 1/4°E, 33.8 FT, (AGREES WITH REC.) 1934

12" NOW 18" DIA. D. FIR WITH A FULLY HEALED DOUBLE BLAZE, BEARS S34°W, 12.0 FT (AGREES WITH REC.) 1960

10" NOW 13" DIA. D. FIR WITH A FULLY HEALED DOUBLE BLAZE, BEARS N50°E, 20.4 FT (AGREES WITH REC.) 1960

8" NOW 8" DIA. DOWN AND ROTTEN D. FIR WITH A FULLY HEALED DOUBLE BLAZE, ROOT HOLE BEARS S62°E, 21.2 FT (AGREES WITH REC.) 1960

Monument Set (Procedure and Description)

Monument Detail

NONE

N/A

New Accessories


19" MADRONE DOUBLE BLAZED AND SCRIBED "T255 R51V 51CS BT"  
BEARS N 37 1/2° E, 55.5 FT

DCSO BC/1A NW COR DLC 43 BEARS NORTH, 36.7 FT

13" WID OAK WITH A NE FACING BLAZE SCRIBED "NW DLC 43 CS BT"  
BEARS N 19° W, 33.3 FT

Sketch of Monument, Accessories, and General Area

Location & Comments

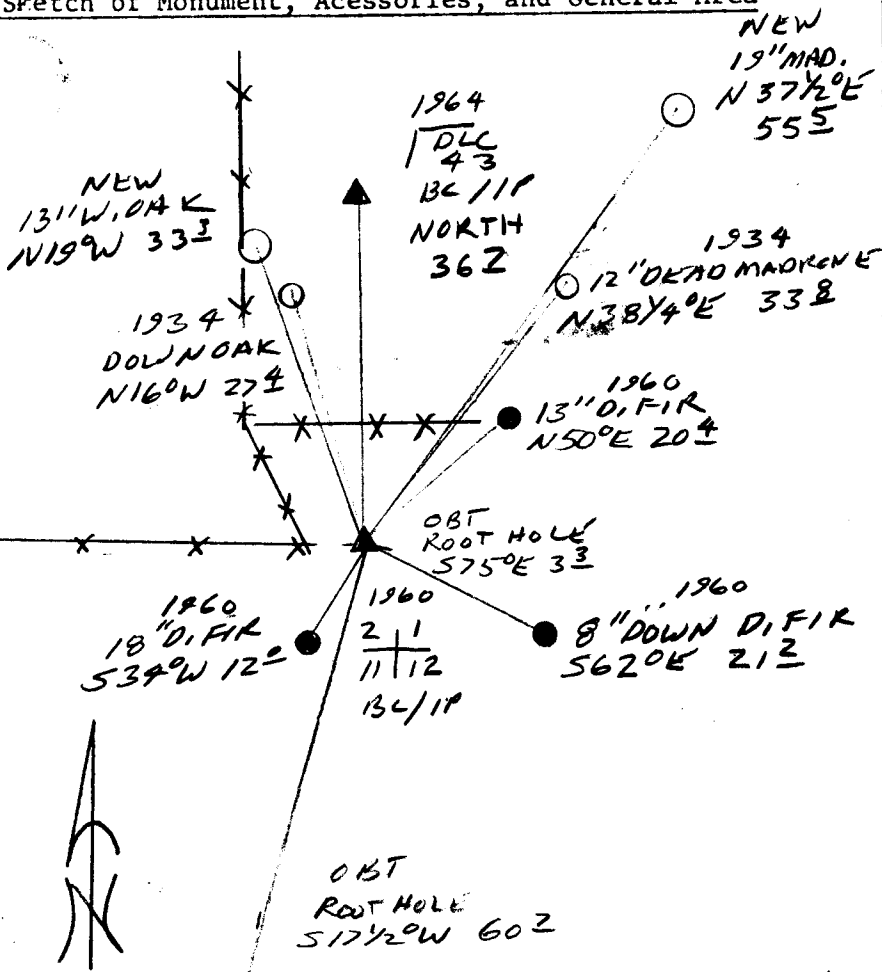

Location & Comments

\_\_\_\_\_

\_\_\_\_\_

Comp. Declin. 17 3/4° E

Agency PCSO

Party Chief RANDALL W. SMITH

Notkeeper J. L. W. SMITH

Witnesses STEPHEN J. FLANNERY

Address \_\_\_\_\_

Surveyor's Seal

REGISTERED PROFESSIONAL LAND SURVEYOR

*Randall W. Smith*

EXPIRES 6-30-98

OREGON  
JULY 25, 1980  
RANDALL W. SMITH  
2489