

GOVERNMENT CORNER RESTORATION FORM

Date: 8-8-97 By: PC

This survey consists of:

Township 25 S Range 6 W Sec. 13 County DOUGLAS Map: _____

State OR Date 8-31-97 No. _____ Narrative: _____

Corner Sp: CS 64/71-28

Corner Designation

NW COR
DLC 58

DOUGLAS COUNTY
SURVEYOR

Condition Report Only

Not Found

Renewed

Unrecorded

Surveyed In

Referenced Out

MONUMENT DETAIL

PI # 058020

Previous Renewals 1938 + 1964 DCSO M61-47

Monument(s) Found: (Condition and Source)

3/4" I.D. IRON PIPE PROTRUDING
8" ABOVE GROUND IN A N-S
FENCE LINE.

ORIG. STONE NOT FOUND
NOR SQUARE HEAD BOLT
NOTED IN 1964 RENEWAL.

N/A

Accessories Found:

NO ORT'S OR BT FROM 1938 RENEWAL FOUND

10" NOW 12" DOWN ASH WITH A UNHEALED BLAZE
SCRIBING VISIBLE "NW DLC 58 CS BT" POSITION
ON ROOT UNKNOWN DOWN BT IS NEAR REC
" N 61 1/2° E 52.0' 1964

12" NOW 13" DIA. ASH WITH A PARTIALLY HEALED
BLAZE SCRIBING VISIBLE "W DLC 58 CS BT"
BEARS' N 64 1/2° E, 46.0 FT (REC N 68° E 45.1 FT)
1964

1/2" I.D. IRON PIPE PROTRUDING 8" ABOVE GROUND
BEARS NORTH 12.50 FT (AGREES WITH REC.)
M 61-47

RENEWAL

Monument Set (Procedure and Description)

Monument Detail

CORNER LIES UNDER A
 FENCE LINE BE/IF
 NOT SET


N/A

New Accessories

5" ASH DOUBLE BLAZED AND SCRIBED "XBT" BEARS N60°E, 32° FT
 4" ASH DOUBLE BLAZED AND SCRIBED "XBT" BEARS N27°E, 17.3 FT

Sketch of Monument, Accessories, and General Area

Location & Comments

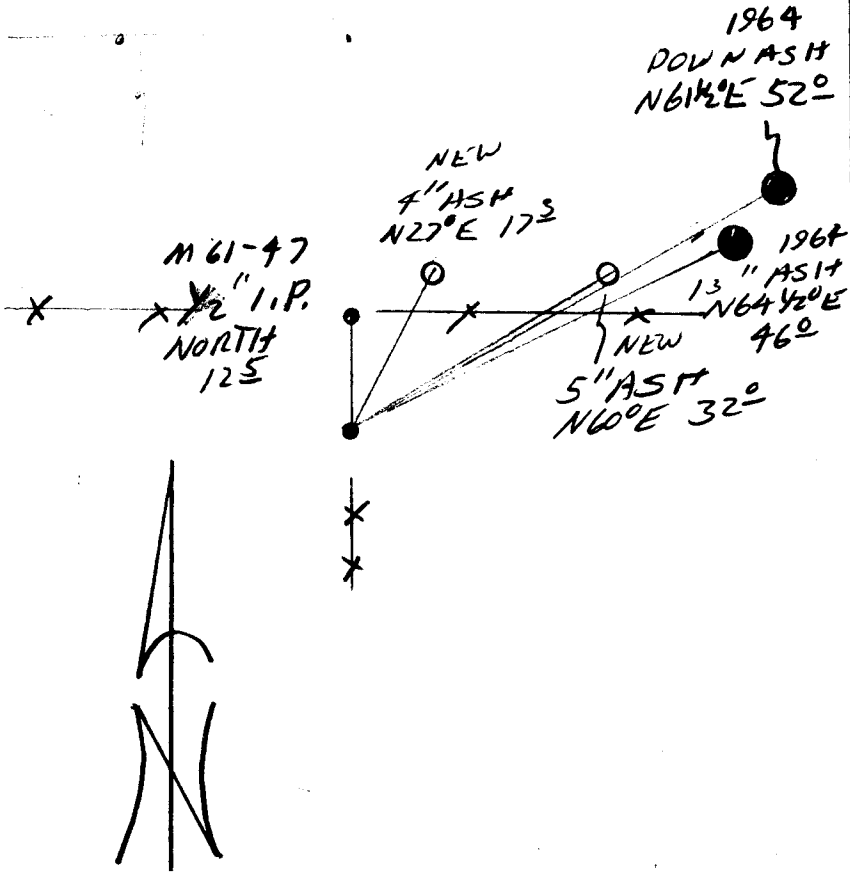

1964
 DOWN ASH
 N61°E 52°

NEW
 4" ASH
 N27°E 17.3

1964
 13" ASH
 N64°E 46°

NEW
 5" ASH
 N60°E 32°

Comp. Declin. 17 3/4° L
 Agency DCSO
 Party Chief RANDALL N SMITH
 Notekeeper [Signature]
 Witnesses STEPHEN J FLYNN

Address

Surveyor's Seal