

GOVERNMENT CORNER RESTORATION FORM

Date: 4/1/1997 By: AC

Township E15 Range 8W Sec. 33 County DOUGLA Map

This survey consists of:

State OR Date 3-17-97 No. _____

Narrative: _____
Corner Rpt: CS 64/74-1

Corner Designation

533 | 534

PI # 413700

Previous Renewals 1883, 1945 + 1959 GLO, 1963 + 1975 DCSO

DOUGLAS COUNTY

Condition Report Only

Not Found

Renewed

Unrecorded

Surveyed In

Referenced Out

MONUMENT DETAIL

Monument(s) Found: (Condition and Source)

M124-44

BE/1P NOT FOUND (1945)

METAL FENCE POST FOUND

OUT OF GROUND (1975)

ALUM NAIL PER M124-44

N/A

Accessories Found:

26" NOW ROTTEN DOWN HEMLOCK INDETERMINABLE SIZE
NO SCRIBING VISIBLE BEARS N 46 3/4° W, 57.4 FT
(AGREES WITH REC.) 1945

8" NOW 10" DIA RED ALDER WITH A PARTIALLY HEALED
DOUBLE BLAZE, ILLIBIBLE SCRIBING VISIBLE,
BEARS N 55° W, 3 FT 7 FT (AGREES WITH REC.) 1975

7" NOW 16" DIA D. FIR WITH A FULLY HEALED DOUBLE
BLAZE, BEARS N 51° E, 22.3 FT (REC N 51° E,
23.6 FT DIST FITS A SLOPE MEASUREMENT) 1975

RENEWAL

Monument Set (Procedure and Description)

Monument Detail


POSITION OF ALUMINUM NAIL IS REFERENCED, A SMALL LEDGE IS CHISELED OUT AND A 2" DIA. BRASS DISK IS CEMENTED ONTO SANDSTONE LEDGE AT POSITION OF REFERENCED NAIL

DCSO
T21S
R 8 W
S33/S34
1997
T22S

New Accessories

16" DIA. D. FIR DOUBLE BLAZED AND SCRIBED
"T21S R 8 W S34 CS BT" BEARS N 27 1/2° E, 35.3 FT
11" DIA. D. FIR DOUBLE BLAZED AND SCRIBED
"T21S R 8 W S33 CS BT" BEARS N 76° W, 8.3 FT

Sketch of Monument, Accessories, and General Area

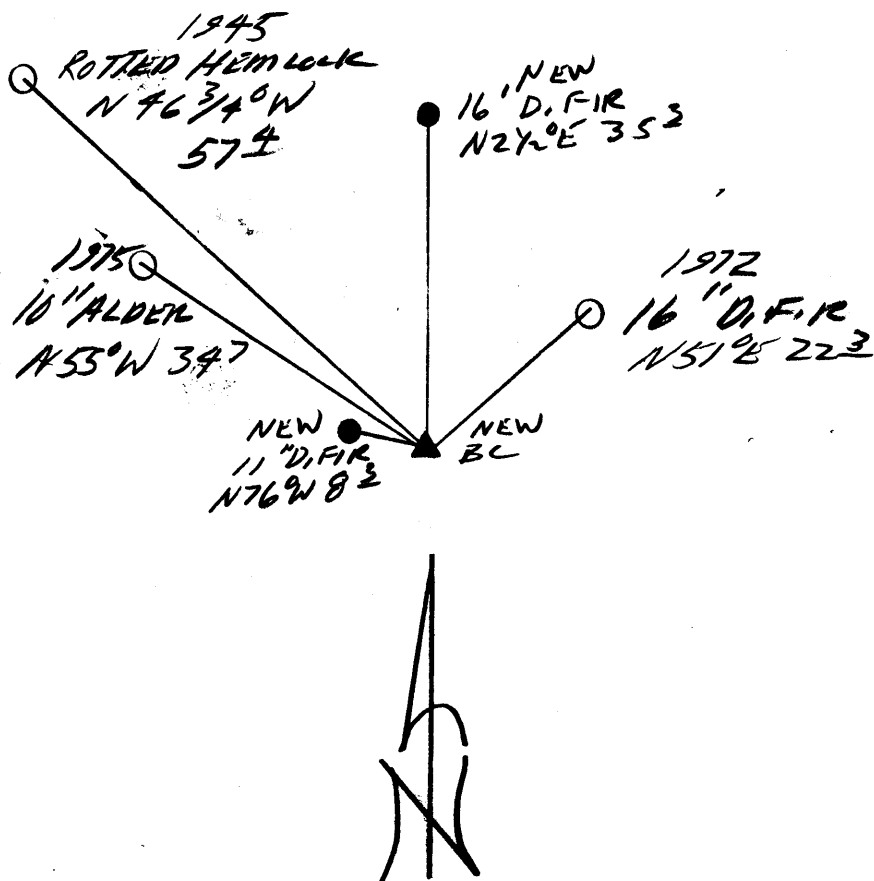

Location & Comments

CORNER LIES ON A STEEP NORTH SLOPE (SANDSTONE AND SHALLOW SOIL).

Comp. Declin. 17 3/4° E
Agency DCSO
Party Chief RANDALL W. SMITH
Notekeeper [Signature]
Witnesses STEPHEN J. FLAHERTY

Address

Surveyor's Seal

REGISTERED PROFESSIONAL LAND SURVEYOR

[Signature]
MARCH 6-30-98

OREGON
JULY 25, 1990
RANDALL W. SMITH
2469