

GOVERNMENT CORNER RESTORATION FORM

Date: 4/3/97 By: PC

This survey consists of:

Township 25S Range 5W Sec. 15 County DOUGLAS Map: \_\_\_\_\_

State OK Date 3-26-97 No. \_\_\_\_\_

Narrative: \_\_\_\_\_  
Corner Act: CS 04/74-2

Corner Designation LOCAL CORNER

DOUGLAS COUNTY

SURVEYOR

Condition Report Only

Not Found

Renewed

Unrecorded

Surveyed In

Referenced Out

MONUMENT DETAIL

DLC  
40

Previous Renewals 1955 VOL 11 pg 5, M100-33

Monument(s) Found: (Condition and Source)

2" O.D. IRON PIPE 8" BELOW  
GROUND. (1955)

N/A

Accessories Found:

1/2" IRON ROD BEARS N43 1/2° W, 68.24 FT  
(AGREES WITH REC. PER M100-33) (PROTRUDES 3" ABOVE  
GROUND)

1/2" IRON ROD BEARS SOUTH 96.0 FT (REC SOUTH,  
94.34 FT PER VOL 11 pg 5 (FLUSH WITH GROUND)

1/2" IRON ROD BEARS SOUTH 190.5 FT (REC SOUTH,  
188.84 FT PER VOL 11 pg 5 (FLUSH WITH GROUND)

RENEWAL

Monument Set (Procedure and Description)

Monument Detail

NONE

N/A


New Accessories

FIRE HYDRANT BEARS N 69° E , 60.0 FT

1" I.D. IRON PIPE BEARS S 41° E , 90.8 FT  
PROTRUDES 6" ABOVE GROUND

Sketch of Monument, Accessories, and General Area

Location & Comments

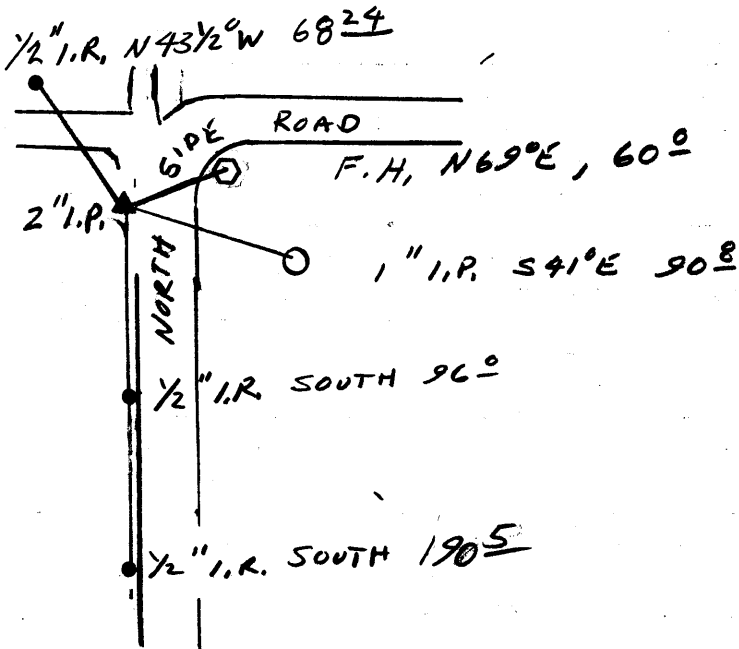

NO CHAIN OF RECORD  
TRACING I.P. BACK TO  
ORIG. CORNER

Comp. Declin. 17 1/4° E  
Agency DCSO  
Party Chief RANDALL W. SMITH  
Notekeeper RANDALL W. SMITH  
Witness STEPHEN J. FLAUS

Address

Surveyor's Seal  
REGISTERED  
PROFESSIONAL  
LAND SURVEYOR

*Randall W. Smith*  
EXPIRES 6-30-98

OREGON  
JULY 25, 1990  
RANDALL W. SMITH  
2489