

GOVERNMENT CORNER RESTORATION FORM

Date: 4/3/97 By: PC

Township 26S Range 6W Sec. 26

County DOUGLAS

This survey consists of:

State OR

Date 3-10-97

No.

Map:

Corner Rpt: CS 04/74-4

Corner Designation

S27/S 26  
S34/S 35

PI # 500200

Previous Renewals 1937 + 1964 DCSC

Monument(s) Found: (Condition and Source)

IP FROM 1937 DCSC  
RENEWAL NOT FOUND

DOUGLAS COUNTY

Condition Report Only

Not Found

Renewed

Unrecorded

Surveyed In

Referenced Out

MONUMENT DETAIL

N/A

Accessories Found:

7" NOW 26" DIA. W/OAK WITH A PREVIOUSLY OPENED FULLY HEALED BLAZE, BEARS N 43 1/2° W, 180.8 FT (AGREES WITH REC.) 1937

12" NOW 13" DIA. W/OAK WITH A FULLY HEALED SINGLE BLAZE, BEARS S 46° E, 70.7 FT (AGREES WITH REC.) 1937

10" NOW 10" DIA. W/OAK WITH A PARTIALLY HEALED ROTTED BLAZE, NO SCRIBING VISIBLE, BEARS N 60 3/4° E, 260.7 FT (REC. N 60 3/4° E, 261.3 FT GOOD SLOPE MEASUREMENT) 1937

10" NOW 13" DIA. DEAD W/OAK WITH A FULLY HEALED BLAZE, TREE IS STANDING IN WATER AT SOUTH END OF A POND, BEARS S 14° W, 333.8 FT (AGREES WITH REC.) 1964

C.S. FILE NO. 04/74-4

RENEWAL

Monument Set (Procedure and Description)

2 3/8" DIA. BRASS CAP ON A 1 3/8" PIP.  
BY 32" LONG IRON PIPE IS SET  
AT A POSITION DETERMINED FROM  
BEARING TREES. BRASS CAP  
PROTRUDES 2" ABOVE GROUND

Monument Detail

DOUGLAS COUNTY SURVEYORS  
T 26 S


R  
527 | 526  
534 | 535  
6  
W

1997  
OFFICE

New Accessories

12" ASH DOUBLE BLAZED AND SCRIBED "T26S R6W S35CS 13T"  
BEARS S 68° E, 107.0 FT

Sketch of Monument, Accessories, and General Area

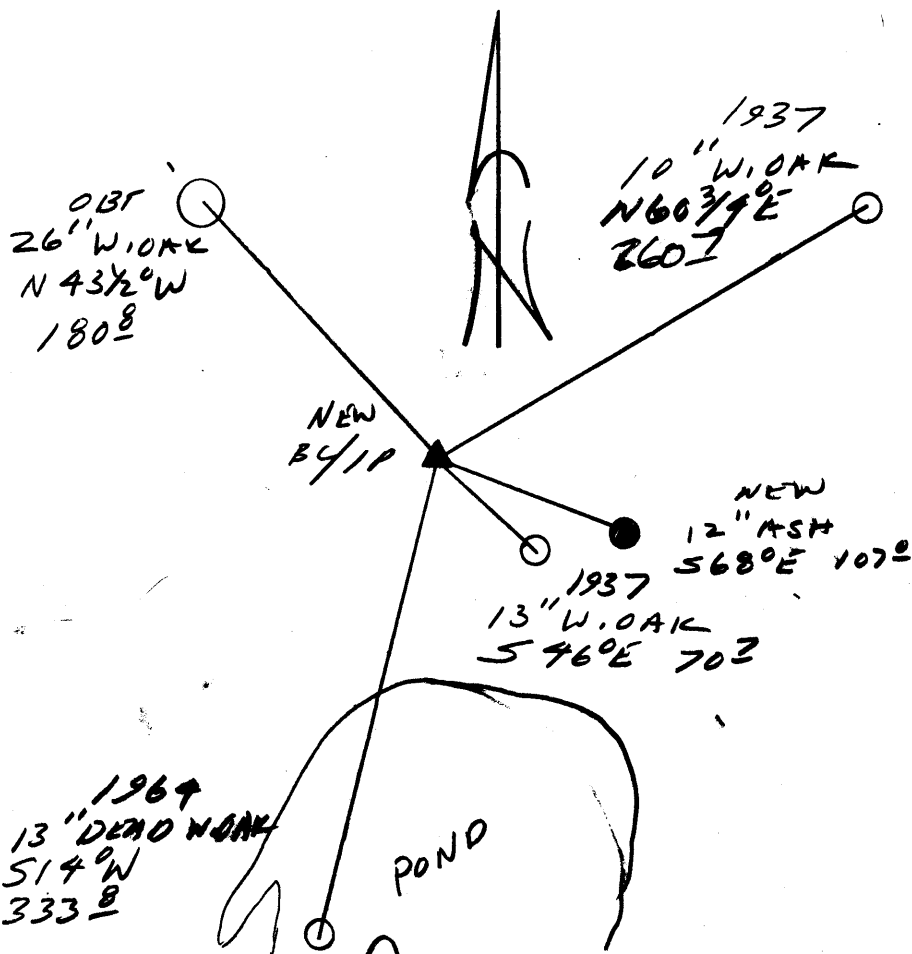

Location & Comments

CORNER LIES IN  
OPEN FIELD APPROX  
200 FT NORTH OF  
A POND

Comp. Declin. 17 3/4° E  
Agency DCSD  
Party Chief RANDALL W. SMITH  
Notekeeper [Signature]  
Witnesses STEPHEN J. FLANKIE

Address

Surveyor's Seal

REGISTERED  
PROFESSIONAL  
LAND SURVEYOR

[Signature]  
EXPIRES 6-30-98

OREGON  
JULY 25, 1990  
RANDALL W. SMITH  
2469