

GOVERNMENT CORNER RESTORATION FORM

Date: 4/21/1997 By: PJC  
This survey consists of:

Township 29S Range 5W Sec. 26 County DOUGLAS Map: \_\_\_\_\_  
State OR Date 4-2-97 No. \_\_\_\_\_ Narrative: \_\_\_\_\_  
Corner Rpt: CS 64/74-9

Corner Designation RENEWED POINT AS  
527 | 526  
534 | 535

DOUGLAS COUNTY SURVEYOR

- Condition Report Only
- Not Found
- Renewed
- Unrecorded
- Surveyed In
- Referenced Out

MONUMENT DETAIL

DETERMINED BY G.E. JOHNSON SEE CS42/32

Previous Renewals 1955 JOHNSON 1963 DCSO

Monument(s) Found: (Condition and Source)

2 1/2" BRASS CAP ON 1 1/2" O.P. IRON PIPE 3" BELOW GROUND 1/4" IS BENT 9" NORTH OF PLUMB. (1963 DCSO)

COUNTY SURVEYORS OFFICE T 29S

527 | 526 R  
534 | 535 S W

1963

Accessories Found:

NO DIST'S FOUND

3/4" IRON ROD BEARS S78 3/4° E, 111.1 FT ON NORTH BANK OF MYRTLE CREEK (REC. S78° 50' E, 102.7 FT ON SOUTH BANK OF MYRTLE CREEK) 1955

NO OTHER ACCESSORIES FROM 1955 RENEWAL FOUND

20" DIA 33" O/D. W. OAK WITH A FULLY HEALED SINGLE BLAZE FACING SW AND A PREVIOUSLY OPENED UNHEALED HOLE FACING NORTHWEST. BEARS S71° E, 129.0 FT (AGREES WITH REC) 1963

3/4" I.R. FROM 1963 RENEWAL NOT FOUND.

Monument Set (Procedure and Description)

BC/IP STRENGTHENED AND RETURNED TO PLUMB POSITION  
 MEASURED 36" LONG, SET 2" BELOW GROUND.


N/A

New Accessories

12" DIA MAPLE DOUBLE BLAZED AND SCRIBED "T2 95 R5W S34 CSBT"  
 BEARS  $S15\frac{1}{2}^{\circ}W$ , 102.1 FT (NOTE TREE HAS FENCE WIRE GROWN INTO TRUNK).

4" DIA MYRTLE DOUBLE BLAZED AND SCRIBED "X BT"  
 BEARS  $S14^{\circ}E$ , 75.4 FT

Sketch of Monument, Accessories, and General Area

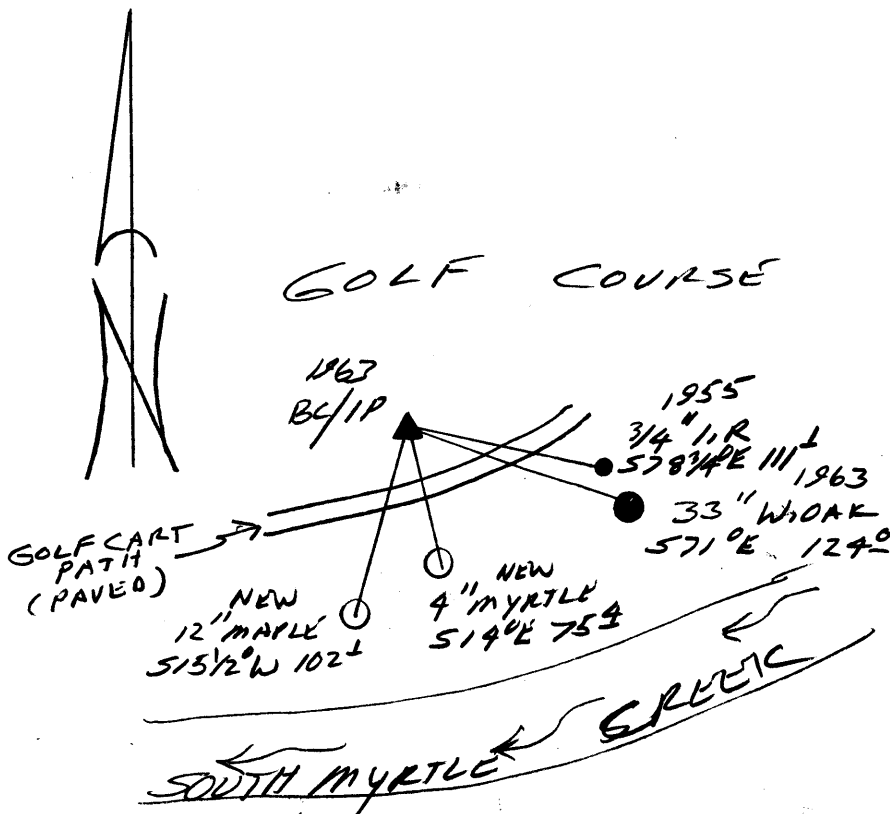

Location & Comments

CORNER LIES APPROX 18 FT NORTHERLY OF PAVED GOLF CART PATH.

A 39" OAK  $S75^{\circ}W$ , 260' FROM BC/IP WAS CHECKED FOR AGE BY TREE BORE FOUND TO BE FAST GROWING NOT LARGE ENOUGH TO BE OBT.

Comp. Declin.  $17\frac{3}{4}^{\circ}E$   
 Agency DCSO  
 Party Chief RANDALL W. SMITH  
 Notekeeper [Signature]  
 Witnesses STEVEN J. FLAUSK

Address

Surveyor's Seal

REGISTERED  
 PROFESSIONAL  
 LAND SURVEYOR

Randall W. Smith  
 EXPIRES 6-30-90

OREGON  
 JULY 25, 1990  
 RANDALL W. SMITH  
 2489