

RENEWAL

Monument Detail

Monument Set (Procedure and Description)

- 8" NOW 16" DIA. D. FIR WITH A FULLY HEALED SINGLE BLAZE, BEARS S 31 1/2° E, 30.4 FT (AGREES WITH REC.) 1957
- 10" NOW 18" DIA. D. FIR WITH A FULLY HEALED SINGLE BLAZE, BEARS S 89 1/2° W, 31.0 FT (AGREES WITH REC.) 1957
- 12" NOW 18" DIA. 1 FT HIGH D. FIR STUMP WITH A HEALED BLAZE, BEARS N 46 1/4° W, 32.3 FT. (AGREES WITH REC.) 1957

N/A

New Accessories

N/A

Sketch of Monument, Accessories, and General Area

SEE ATTACHED SKETCH

Location & Comments

Comp. Declin. 17 3/4° E
 Agency DCSO
 Party Chief RANDALL W. SMITH
 Notekeeper [Signature]
 Witnesses STEPHEN J. FIAUSE

Address

Surveyor's Seal


REGISTERED
 PROFESSIONAL
 LAND SURVEYOR

[Signature]
 EXPIRES 6-30-98

OREGON
 JULY 25, 1990
 RANDALL W. SMITH
 2469

(NOTE ORIG RECOF
N 30°W 99 FT WOOD
BIT ROOT HOLE FROM
EITHER MONUMENT)

AK

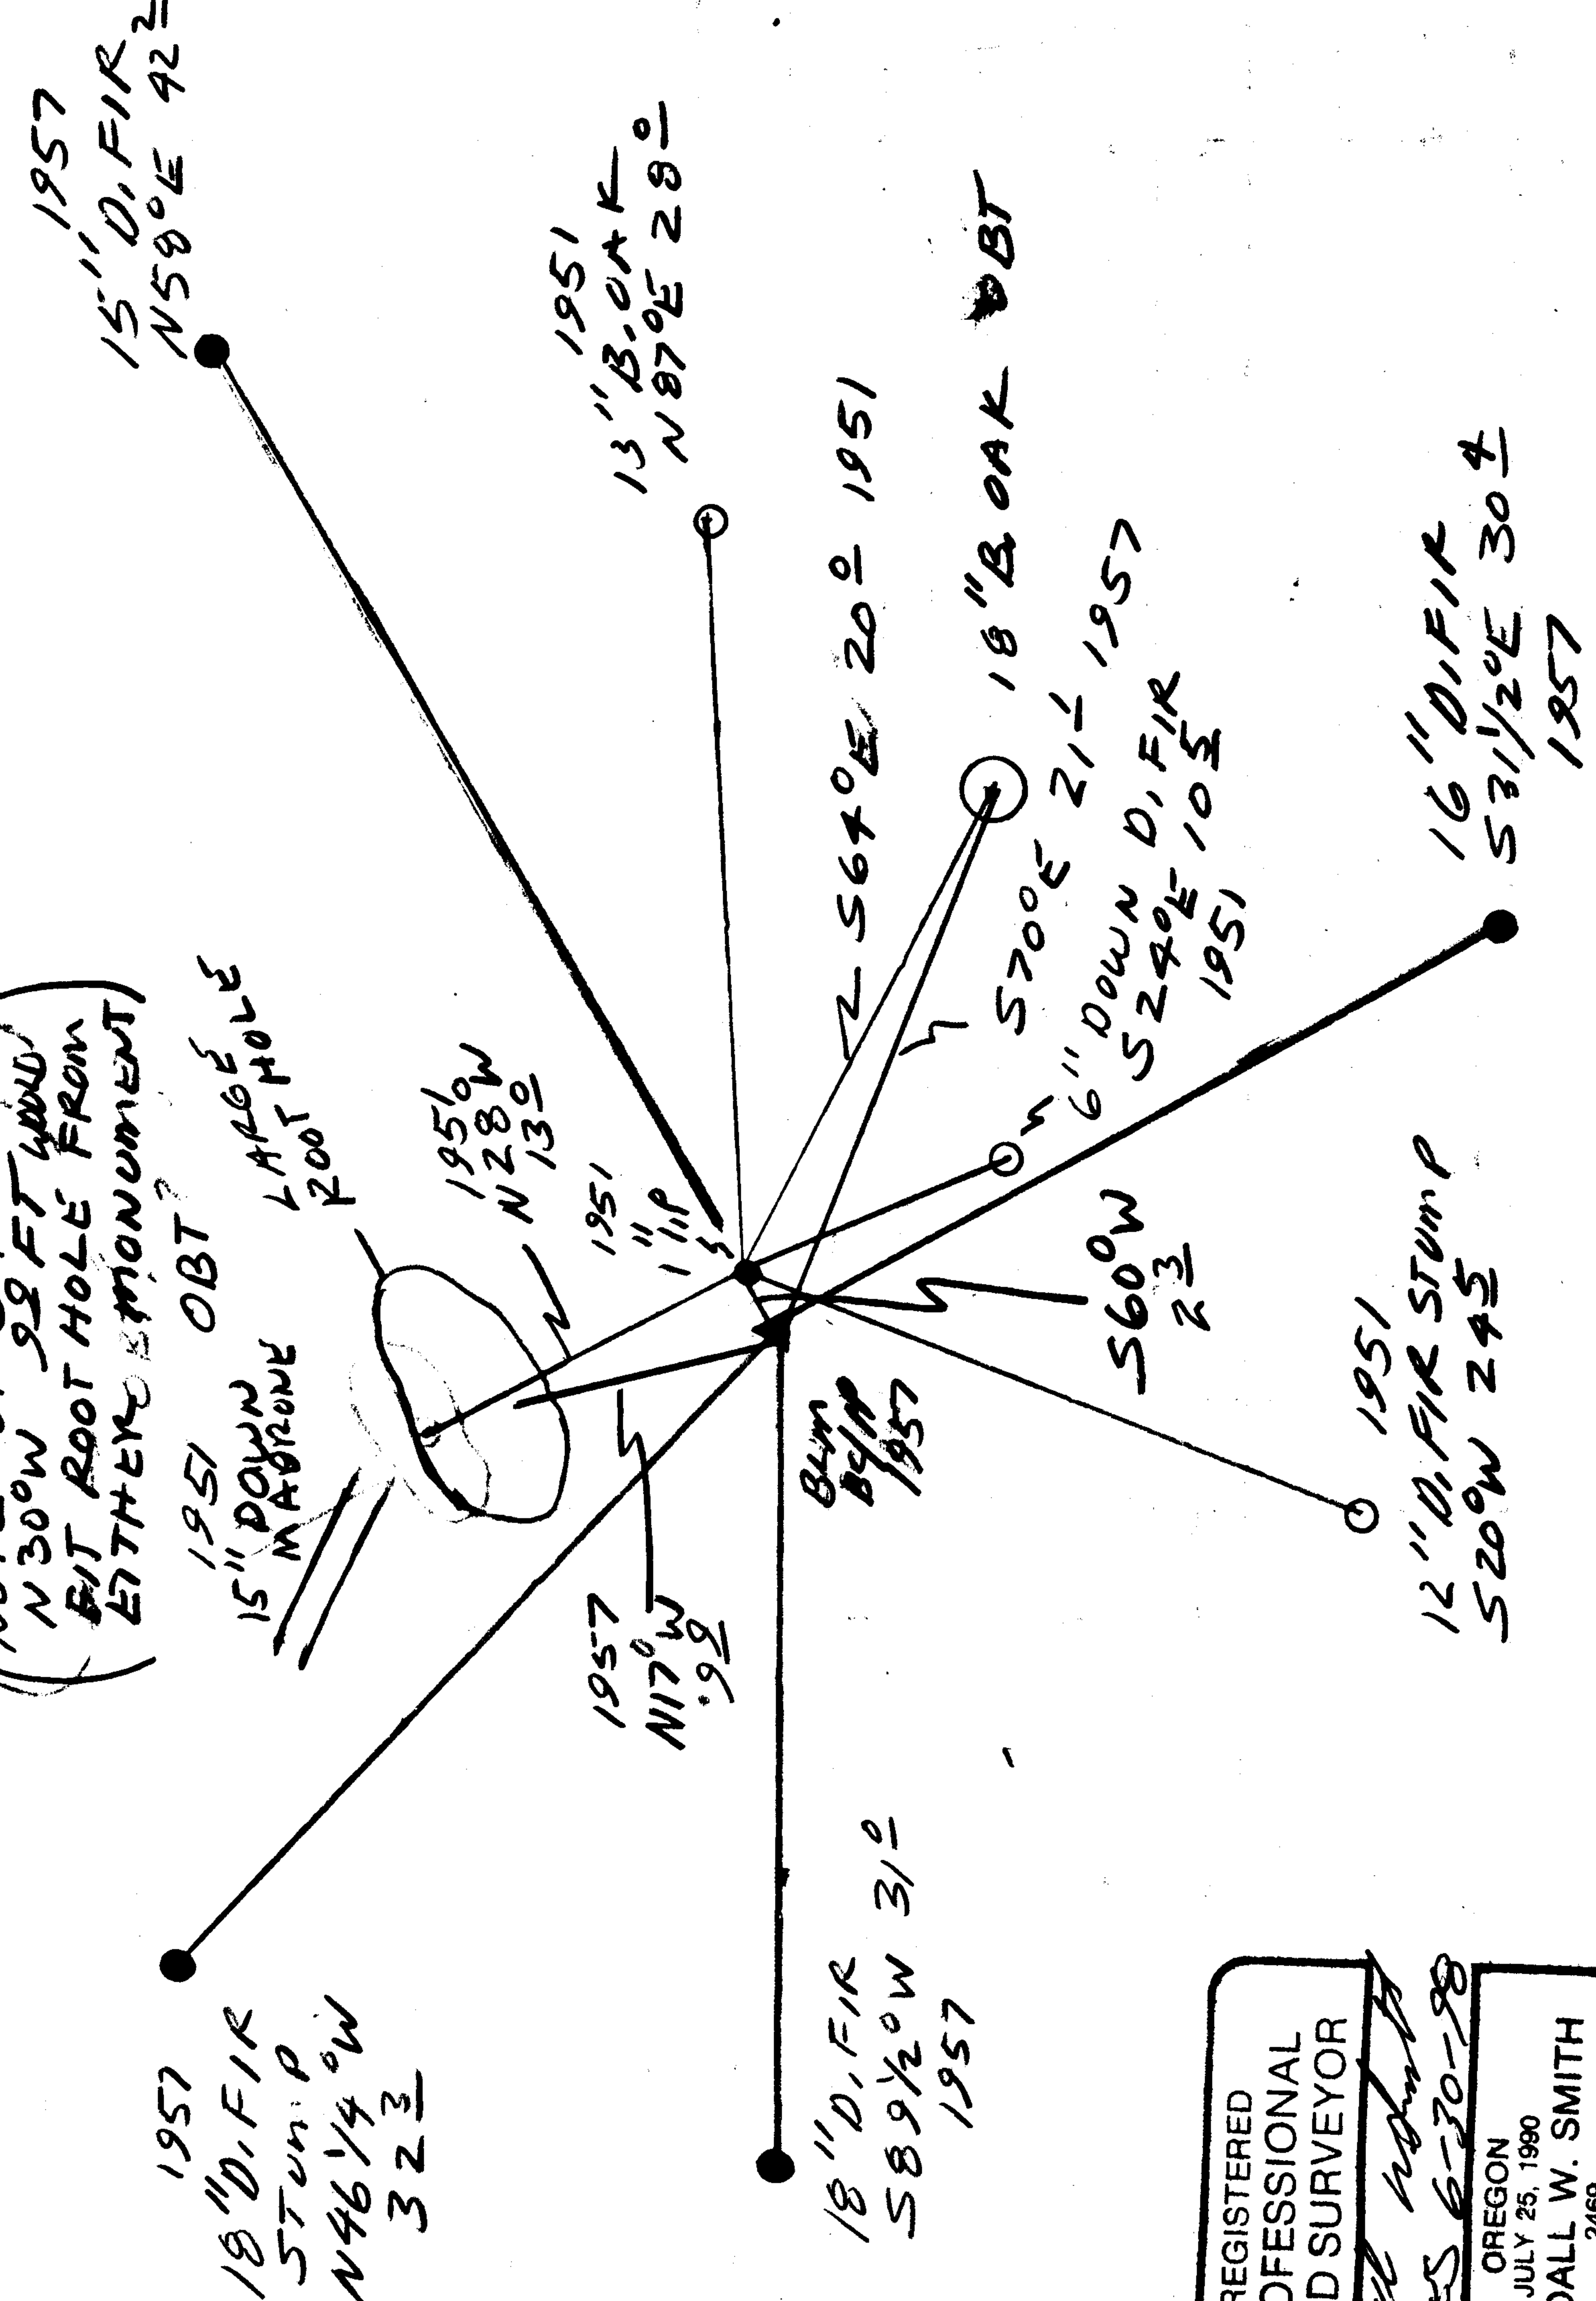

REGISTERED
PROFESSIONAL
LAND SURVEYOR

Randall W. Smith

EXPIRES 6-30-98

OREGON
JULY 25, 1980
RANDALL W. SMITH
2469