

Monument Set (Procedure and Description)

Monument Detail

NONE


N/A

New Accessories

BLAZED AND

- 8" DIA. B. OAK DOUBLE Y SCRIBED "T28SR 7/2 WS6 CS BT BEARS N 84° E, 25.3 FT.
- 11" DIA. I. CEDAR DOUBLE BLAZED AND SCRIBED "T28SR 7/2 WS6 CS BT BEARS S 86° W, 2.4 FT.
- 3" DIA. D. FIR DOUBLE BLAZED AND SCRIBED "X BT" BEARS S 40° W, 15.4 FT.

Sketch of Monument, Accessories, and General Area

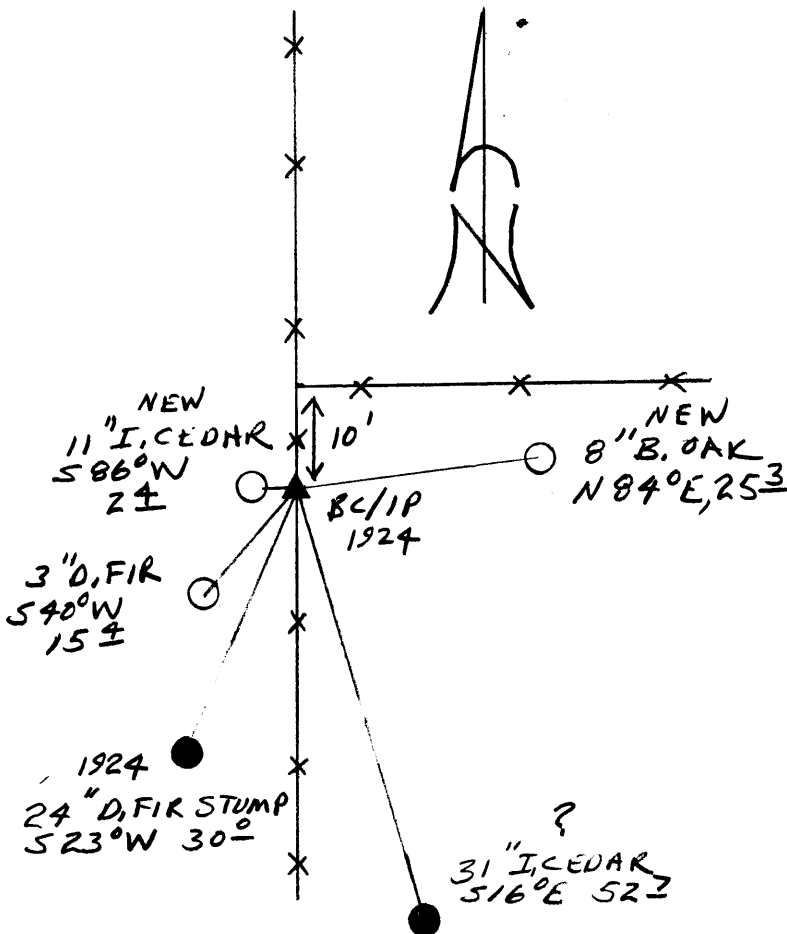

Location & Comments

CORNER LIES IN A NORTH-SOUTH FENCE LINE 10' SOUTH OF A FENCE RUNNING EAST

Comp. Declin. 17 3/4° E
 Agency DCS
 Party Chief RANDALL W. SMITH
 Notekeeper [Signature]
 Witnesses STEVEN J. FLAUS

Address

Surveyor's Seal

REGISTERED PROFESSIONAL LAND SURVEYOR

Randall W. Smith
EXPIRES 6-30-98

OREGON
JULY 25, 1990
RANDALL W. SMITH
2469