

GOVERNMENT CORNER RESTORATION FORM

Date: 5-22-1977 By: BC

Township 27S Range 8W Sec. 25 County DOUGLAS

This survey consists of:

State OR

Date 5-14-97

No. _____

Narrative: _____

County Rpt: CS 64/74-32

Corner Designation

$\frac{1}{4}$ $\frac{S25}{S36}$

DOUGLAS COUNTY
SURVEYOR

Condition Only

Not Found

Renewed

Unrecorded

Surveyed In

Referenced Out

MONUMENT DETAIL

Previous Renewals NONE OF RECORD

Monument(s) Found: (Condition and Source)

NONE

N/A

Accessories Found:

48" DIA 2 1/2' HIGH D. FIR STUMP WITH A W.T.C.O. CORNER TAG NAILED ON TOP, NO BLAZES VISIBLE, TAG READS "14.7 FT N 38° W TO N 1/4 COR T27S R8W S.36 JFE 8-21-72 NOD 7-11-52".

12" DIA D. FIR WITH FLAGGING PROTRUDING FROM A SMALL HEALED BLAZE, POSSIBLE W NAIL INSIDE BLAZE, W.T.C.O. CORNER TAG READS "15.6 FT S 07 1/2° E TO S 1/4 T27S R8W S25"

(NOTE ABOVE TREES MAKE AN INTERSECTION)

14" DIA 12' HIGH CEDAR SNAG WITH AXE MARKS W.T.C.O. TAG READS "T27S R8W S36 N 1/4 MTH JFE 8-21-72 RJ OH 8-72" THIS TREE IS APPROX SOUTH 8' FT FROM A CALC. CORNER POSITION DETERMINED FROM ABOVE TREES.

RENEWAL

Monument Set (Procedure and Description)

Monument Detail


NONE

N/A

New Accessories

NONE

Sketch of Monument, Accessories, and General Area

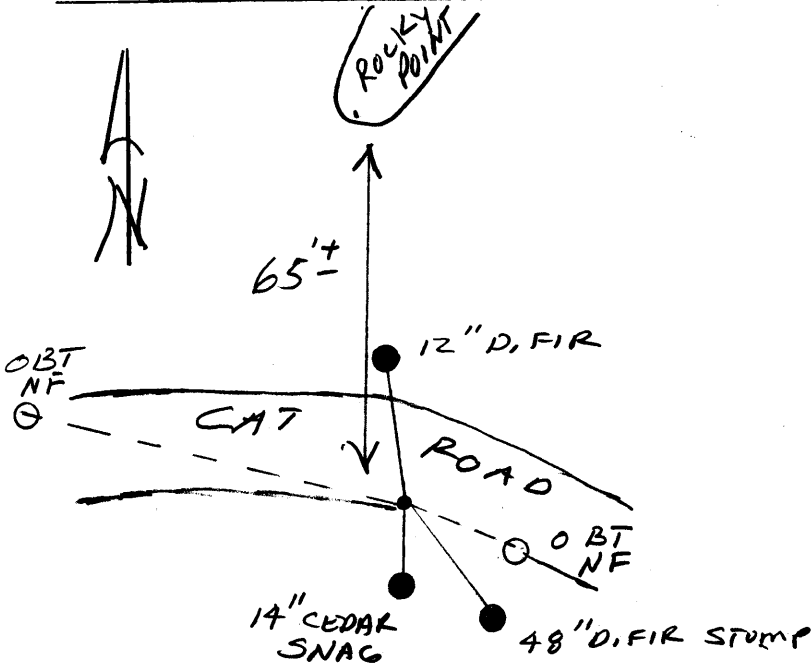

Location & Comments

POSITION OF OBT'S
FALL AT EDGE OF
CAT ROAD

NOTE THIS CORNER
NOT RENEWED IN 1983
BY DCSO SEE
CS 58/271

Comp. Declin. 17 3/4° E
Agency DCSO
Party Chief RANDALL W. SMITH
Notekeeper STEVEN J. FLAISE
Witnesses STEVEN J. FLAISE

Address

Surveyor's Seal

REGISTERED
PROFESSIONAL
LAND SURVEYOR

Randall W. Smith
EXPIRES 6-30-98

OREGON
JULY 25, 1990
RANDALL W. SMITH
2469