



RENEWAL

Monument Set (Procedure and Description)

NONE


Monument Detail

N/A

New Accessories

NONE

Sketch of Monument, Accessories, and General Area

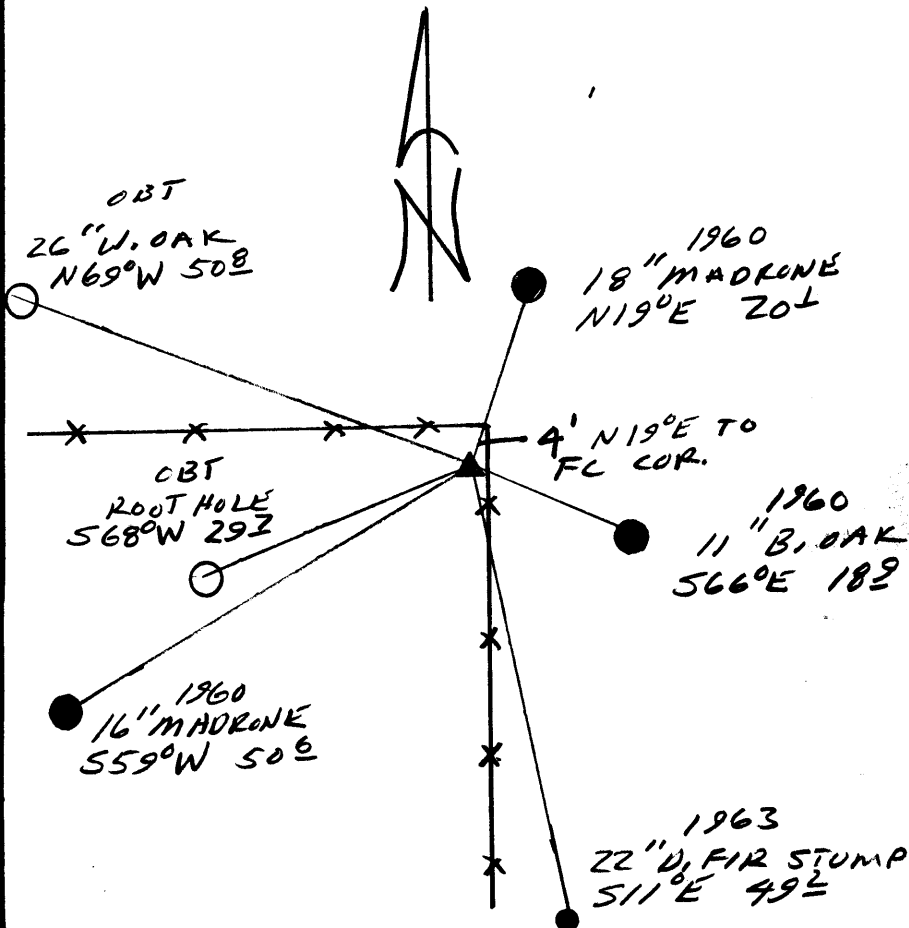

Location & Comments

FENCE CORNER WITH  
FENCE RUNNING SOUTH  
AND WEST BEARS  
N19°E 9.0 FT

Comp. Declin. 17<sup>3</sup>/<sub>4</sub>°E  
 Agency DCSG  
 Party Chief RANDALL W. SMITH  
 Notekeeper [Signature]  
 Witnesses STEPHEN J. FLAUSCH

Address

Surveyor's Seal

REGISTERED  
PROFESSIONAL  
LAND SURVEYOR

[Signature]  
EXPIRES 6-30-98

OREGON  
JULY 25, 1990  
RANDALL W. SMITH  
2469