

GOVERNMENT CORNER RESTORATION FORM

Date 5.30.1997 By: BC

Township 25S Range 5W Sec. 7 County DOUGLAS

This survey consists of:

State OR Date 5-28-97 No. \_\_\_\_\_

Comptrol CS 64/74 -37

Corner Designation

W.C. 99.8 FT TO  
1/4 S12 | S7

DOUGLAS COUNTY

Condition Report Only

Not Found

Renewed

Unrecorded

Surveyed In

Referenced Out

MONUMENT DETAIL

Previous Renewals 1972 DCSO PI #100540

Monument(s) Found: (Condition and Source)

NOT FOUND

N/A

Accessories Found:

27" NOW 30" DIA DOWN ON FACE ASH, ROOT HOLE  
AGREES WITH RECORD " N46°W, 15.6 FT (1972)

14" NOW NORTHEAST TRUNKED MAPLE WITH A FULLY  
HEALED SINGLE BLAZE ON 18" DIA EASTERN  
TRUNK. WE OPENED A SMALL HOLE OVER BLAZE  
AND FOUND A SMALL SCRIBE MARK. ROOT  
CROWN OF EASTERN SCRIBED TRUNK BEARS  
S73°E, 62.0 FT. (AGREES WITH REC. (1972)

Monument Set (Procedure and Description)

2 3/8" DIA BRASS CAPINA 1 3/8"  
O.D. BY 32" LONG IRON PIPE  
AT A POSITION DETERMINED  
FROM 1972 DCSO BT'S. BC/IP  
IS SET FLUSH WITH GROUND.

DOUGLAS COUNTY SURVEYORS

T25 S

W, C, 99.8 FT N. TO  
R N. TO R  
6 1/4 512 / 575  
W W

1997  
OFFICE


159

New Accessories

1 1/2" DIA ASH DOUBLE BLAZED AND SCRIBED "W.C. 1/4 512 CS BT"  
BEARS N 61 1/2° W, 19.0 FT

9" DIA ASH DOUBLE BLAZED AND SCRIBED "W.C. 1/4 512 CS BT"  
S 73° W 40.5 FT  
(NOTE NO OTHER SUITABLE TREES FOUND IN AREA)

Sketch of Monument, Accessories, and General Area

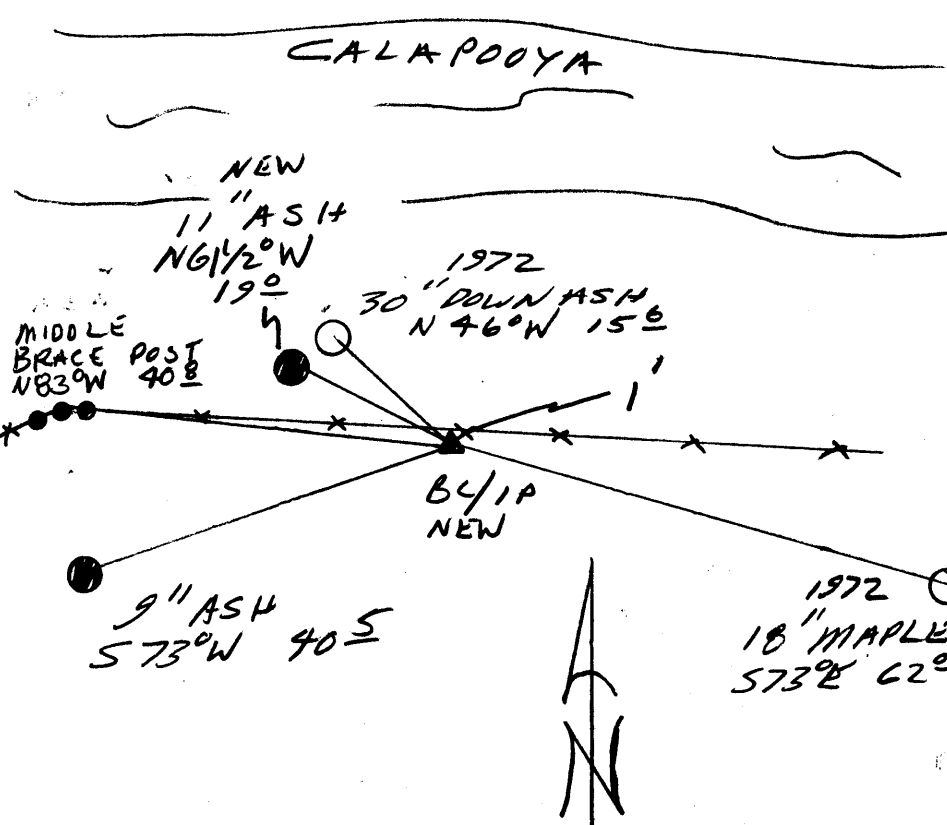

Location & Comments

CORNER LIES 1 FT  
SOUTH OF A RANDOM  
CREEK LINE FENCE.  
W.C. LIES APPROX  
15' SOUTH OF SOUTH  
BANK OF CALAPOOYA  
CREEK

Comp. Declin. 173/4° E  
Agency DCSO  
Party Chief RANDALL W. SMITH  
Notekeeper  
Witnesses STEPHEN J. FINSE

Address

Surveyor's Seal

REGISTERED  
PROFESSIONAL  
LAND SURVEYOR  
Randall W. Smith  
EXPIRES 6-30-28  
OREGON  
JULY 25, 1990  
RANDALL W. SMITH  
2489