

GOVERNMENT CORNER RESTORATION FORM

Date: 6/5/97 By: BC

Township 24S Range 5W Sec. 31 County DOUGLAS

This survey consists of:

State OR Date 5-26-97 No. \_\_\_\_\_

Map: \_\_\_\_\_  
Narrative: \_\_\_\_\_  
Corner Rpt: CS 64/74-39

Corner Designation

WIT. COR  
S31 | S32  
S6 | S5

25' SOUTH  
TO CORNER

DOUGLAS COUNTY  
SURVEYOR Only

- Condition Only
- Not Found
- Renewed
- Unrecorded
- Surveyed In
- Referenced Out

Previous Renewals 1975 DCSO

Monument(s) Found: (Condition and Source)

1" O.D. IRON PIPE, 2" BELOW  
GROUND. BRASS CAP GONE.  
1975

N/A

Accessories Found:

6" NOW 10" DIA ASH WITH A PARTIALLY HEALED  
DOUBLE BLAZE, ILLEGIBLE SCRIBING VISIBLE BEARS  
S90°W, 21.3 FT. (AGREES WITH REC.) 1975

3" NOW 12" DIA W. OAK WITH A FULLY HEALED  
DOUBLE BLAZE, BEARS S29°E, 3.6 FT (AGREES  
WITH REC.) 1975

RENEWAL

Monument Set (Procedure and Description)

2 7/8" DIA. BRASS CAPON A 1 3/8"  
 BY 32" LONG IRON PIPE IS  
 SET AT POSITION OR  
 FOUND 1" I.P. BRASS CAP  
 I.P. PROTRUDES 6" ABOVE  
 GROUND. FD I.P. MEASUREMENT  
 24" LONG IS SET ALONG EAST EDGE  
 OF BC I.P. PROTRUDES 1"  
 ABOVE GROUND.


Monument Detail

DOUGLAS COUNTY SURVEYORS  
 T 2 + S  
 WC 31 | 32 R 5  
 6 | 5 W  
 T 255  
 COR 25 FT SOUTH  
 1997  
 OFFICE

New Accessories

9" DIA. W. OAK DOUBLE BLAZED AND SCRIBED "N 20 1/2° E 21.3 FT"  
 BEARS N 20 1/2° E, 21.3 FT  
 8" DIA. W. OAK DOUBLE BLAZED AND SCRIBED "N 24 1/2° W 122.5 FT"  
 BEARS N 24 1/2° W, 122.5 FT

Sketch of Monument, Accessories, and General Area

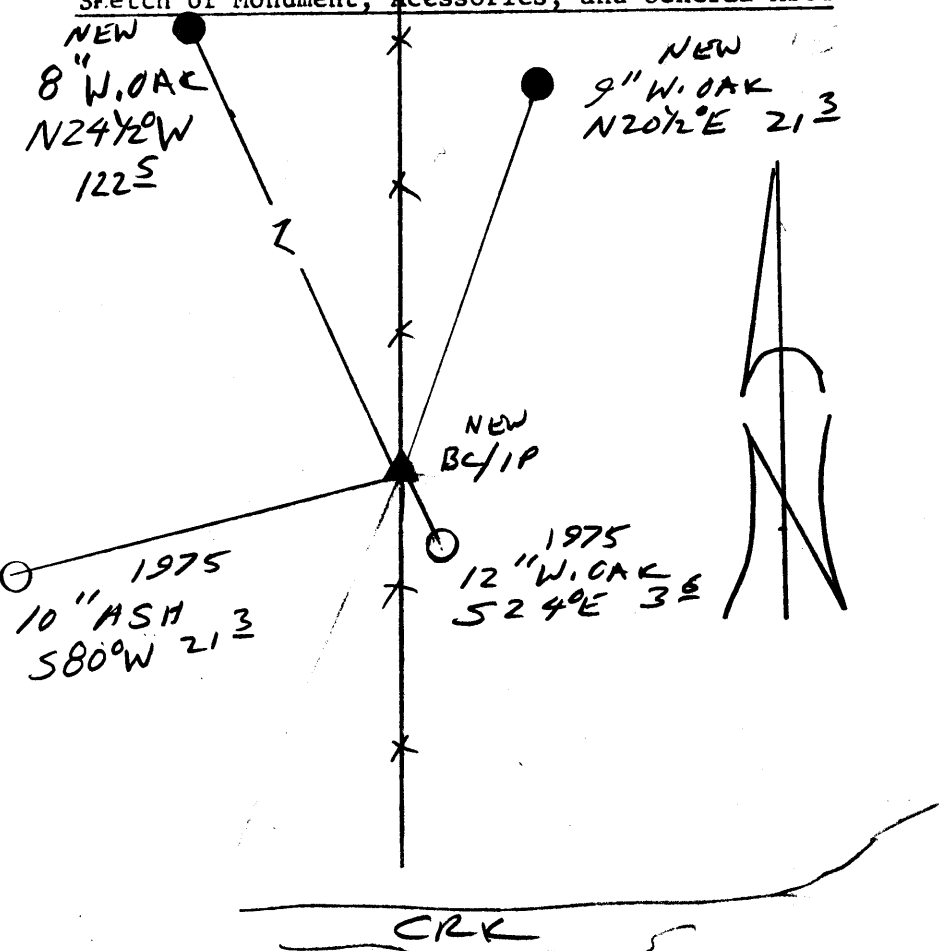

Location & Comments

CORNER LIES 6" EAST  
 OF A N-S FENCE LINE  
 30 FT NORTH OF A  
 SMALL CREEK

Comp. Declin. 17 3/4° E  
 Agency DCSO  
 Party Chief RANDALL W. SMITH  
 Notekeeper [Signature]  
 Witnesses STEPHEN J. FLAUS

Address

Surveyor's Seal

REGISTERED  
 PROFESSIONAL  
 LAND SURVEYOR

[Signature]

EXPIRES 6-30-98

OREGON  
 JULY 25, 1990  
 RANDALL W. SMITH  
 2488