

RENEWAL

Monument Set (Procedure and Description)

Monument Detail

THE PLUMB POSITION OF FOUND IRON PIPE IS REFERENCED AND I.P. REMOVED. MEASURED 24" LONG. A 2 3/8" DIA BRASS CAP ON A 1 7/8" OD BY 32" LONG IRON PIPE IS SET AT REFERENCED POSITION, PROTRUDES 3" ABOVE GROUND. I.P. IS SET ALONG NORTH EDGE OF BC/IP SET FLUSH WITH GROUND.


DOUGLAS COUNTY SURVEYORS
 T 245
 1/4 S 31 R
 S 6 5
 W
 T 255
 1997
 OFFICE

New Accessories

8" D. FIR DOUBLE BLAZED AND SCRIBED "Y456CS BT"
 BEARS S 74 1/2° E 176.0 FT
 30" B. OAK DOUBLE BLAZED AND SCRIBED "Y4531CS BT"
 BEARS N 65° W 156.0 FT
 26" W. OAK SINGLE BLAZED AND SCRIBED "Y4531CS BT"
 BEARS N 22° E 41.3 FT

Sketch of Monument, Accessories, and General Area

Location & Comments

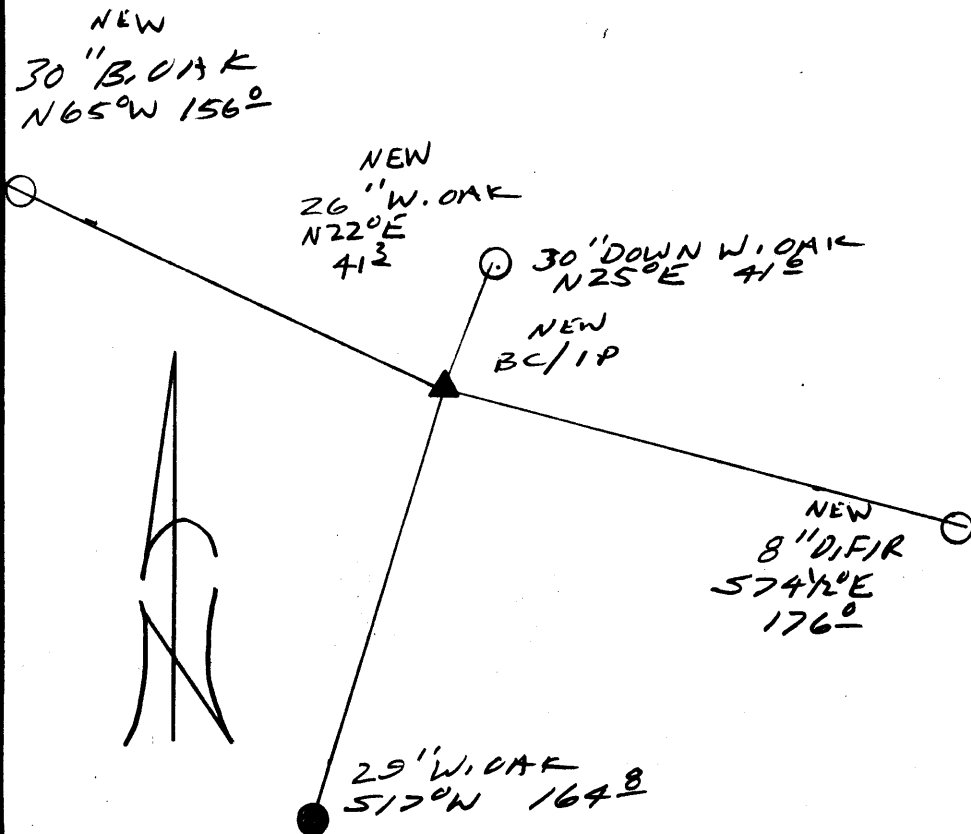

Location & Comments

Comp. Declin. 17 3/4° E
 Agency DC SO
 Party Chief RANDALL W. SMITH
 Notekeeper
 Witnesses STEPHEN J. FLAHERTY

Address

Surveyor's Seal

REGISTERED PROFESSIONAL LAND SURVEYOR

Randall W. Smith
 EXPIRES 6-30-98

OREGON
 JULY 25, 1990
 RANDALL W. SMITH
 2469