

Monument Set (Procedure and Description)

Monument Detail

NAME


N/A

New Accessories

- 16" DIA. W. OAK DOUBLE BLAZED AND SCRIBED "Y4S31CSBT"
BEARS N 47° E 38.5 FT
- 21" DIA. W. OAK DOUBLE BLAZED AND SCRIBED "Y4S31CSBT"
BEARS S 88° E 52.6 FT
- 28" DIA. 13.0 AK DOUBLE BLAZED AND SCRIBED "Y4S36CSBT"
BEARS S 73 1/2° W 168.9 FT

Sketch of Monument, Accessories, and General Area

Location & Comments

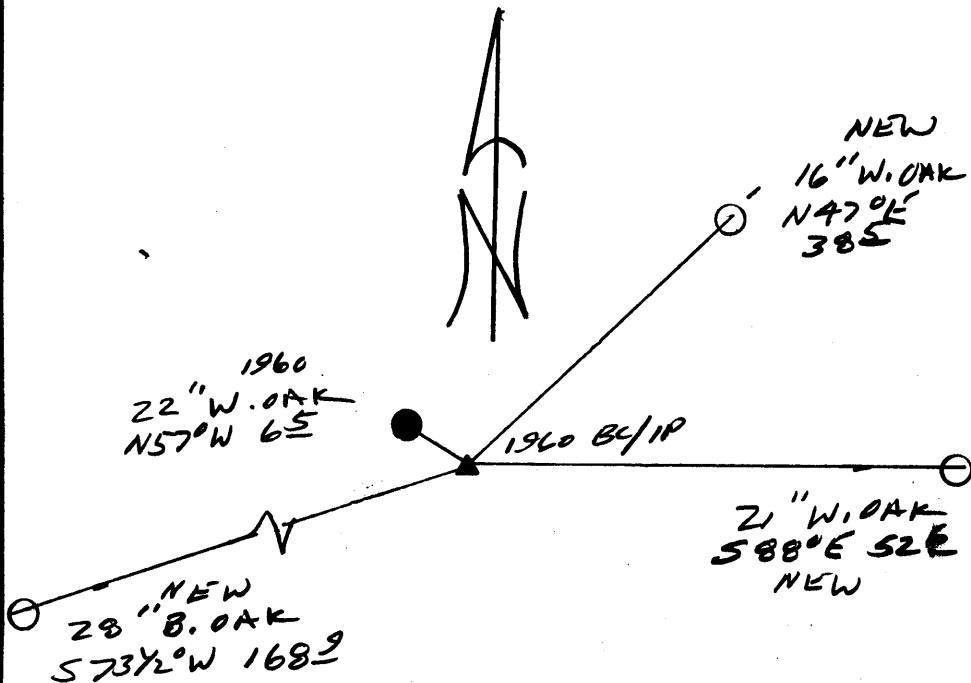

Location & Comments

Comp. Declin. 17 3/4° E

Agency DCSG

Party Chief RANDALL W. SMITH

Notekeeper Charles H. [unclear]

Witnesses STEPHEN J. FLAUB

Address _____

Surveyor's Seal

REGISTERED
PROFESSIONAL
LAND SURVEYOR

Randall W. Smith
EXPIRES 6-30-98

OREGON
JULY 25, 1990
RANDALL W. SMITH
2469