

GOVERNMENT CORNER RESTORATION FORM

Date: 6/5/97 By: BC

Township 23S Range 5W Sec. 28 County DOUGLAS

This survey consists of: \_\_\_\_\_  
Map: \_\_\_\_\_

State OR Date 6-2-97 No. \_\_\_\_\_

Narrative: \_\_\_\_\_

Corner Designation

SW COR  
DLC 47

Corner Fpt: CS 64/75-5

- DOUGLAS COUNTY SURVEYOR
- Condition Only
  - Not Found \_\_\_\_\_
  - Renewed
  - Unrecorded \_\_\_\_\_
  - Surveyed In \_\_\_\_\_
  - Referenced Out \_\_\_\_\_

Previous Renewals 1964 SHANER PT# 047050

MONUMENT DETAIL

Monument(s) Found: (Condition and Source)

5/8" I.R. PROTRUDING 7" ABOVE GROUND (1964)

TOP OF A 5" X 5" STONE IS FOUND 2" BELOW GROUND WITH THE MARKS "C 47". STONE IS ALONG NORTH EDGE OF I.R. (ORIG. CORNER STONE).

N/A

Accessories Found:

- ORIG. SW BT GONE
- 10" NW 36" DIA. B. OAK WITH A PARTIALLY HEALED PREVIOUSLY OPENED ROTTED BLAZE NO MARKS VISIBLE BEARS N50E, 21.5 FT (REC N50E, 20.5 FT DIST IS A FACE MEASUREMENT) OBS
- 30" NW 36" DIA. 4 FT HIGH D. FIR STUMP WITH A FULLY HEALED SINGLE BLAZE BEARS N22°E, 112.9 (REC N21°E 110.7 FT DIST IS A FACE MEASUREMENT) 1964
- 12" NW 30" DIA 1 1/2 FT HIGH D. FIR STUMP WITH A FULLY HEALED SINGLE BLAZE BEARS S57°20'W, 55.5 FT (REC S55°W, 54.5 FT DIST. IS A FACE MEASUREMENT) 1964

ALL B.R.G.'S + DIST. TAKEN TO I.R.

Monument Set (Procedure and Description)

Monument Detail

NONE

N/A

BKG'S + DIST TAKEN TO I.R.


New Accessories

6" DIA. HAWTHORN, DOUBLE BLAZED AND SCRIBED  
"SW DLC 47 CS BT" BEARS N 34°E, 26.6 FT

8" DIA. W. OAK, DOUBLE BLAZED AND SCRIBED  
"SW DLC 47 CS BT" BEARS N 71 1/2°E, 48.0 FT

19" DIA. MAPLE, DOUBLE BLAZED AND SCRIBED "SW DLC 47 CS BT"  
BEARS 55 1/2°W, 66.0 FT.

Sketch of Monument, Accessories, and General Area

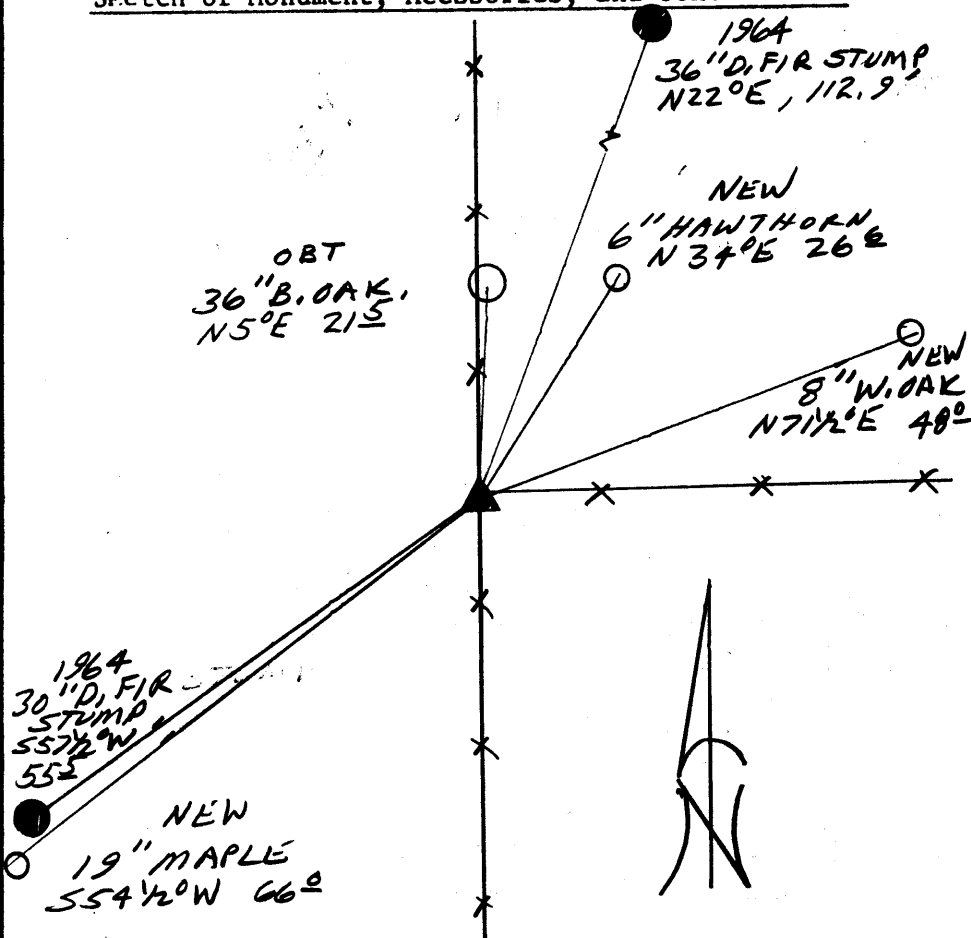

Location & Comments

CORNER LIES AT THE  
INTERSECTION OF A N-S  
AND E RUNNING FENCE  
LINES

Comp. Declin. 17 3/4 0' E  
Agency PCSO  
Party Chief RANDALL W. SMITH  
Notekeeper [Signature]  
Witnesses STEVEN J. FLAVIS

Address

Surveyor's Seal

REGISTERED  
PROFESSIONAL  
LAND SURVEYOR

Randall W. Smith  
EXPIRES 6-30-98

OREGON  
JULY 25, 1990  
RANDALL W. SMITH  
2489