



Monument Set (Procedure and Description)

Monument Detail

NONE


N/A

New Accessories

13" DIA MADRONE DOUBLE BLAZED AND SCRIBED "TZSSR5WS10CSBT"  
BEARS S22 1/2 W 38.3 FT

3" DIA. D.FIR DOUBLE BLAZED AND SCRIBED "XBT"  
BEARS N54°E 15.8 FT

Sketch of Monument, Accessories, and General Area

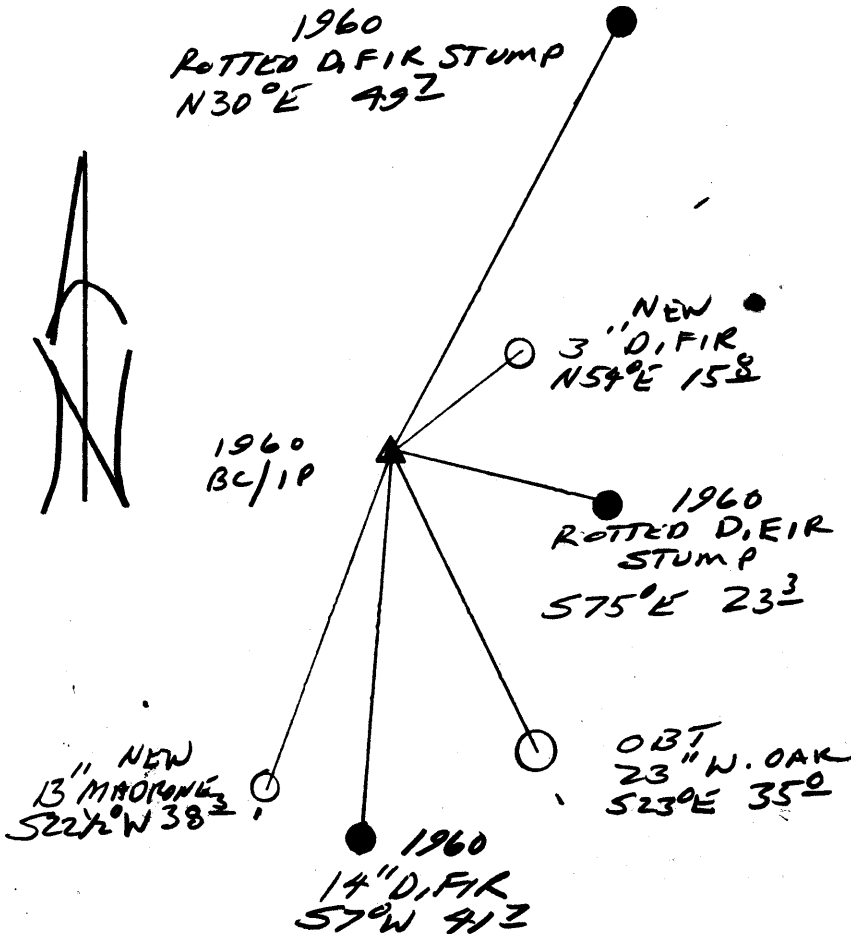

Location & Comments

CORNER LIES APPROX  
SOUTH 65 FT FROM  
A GRAVEL ROAD

Comp. Declin. 17 3/4° E  
Agency DCSO  
Party Chief RANDALL W. SMITH  
Notekeeper [Signature]  
Witnesses STEPHEN T. FEAUSE

Address

Surveyor's Seal

REGISTERED  
PROFESSIONAL  
LAND SURVEYOR

[Signature]

OREGON  
JULY 25, 1990  
RANDALL W. SMITH  
2469