



Monument Set (Procedure and Description)

Monument Detail


NONE

N/A

New Accessories

14" DIA. D.FIR DOUBLE BLAZED AND SCRIBED "SSW DLC 58 CS BT"  
BEARS N53°W, 30.1 FT

Sketch of Monument, Accessories, and General Area

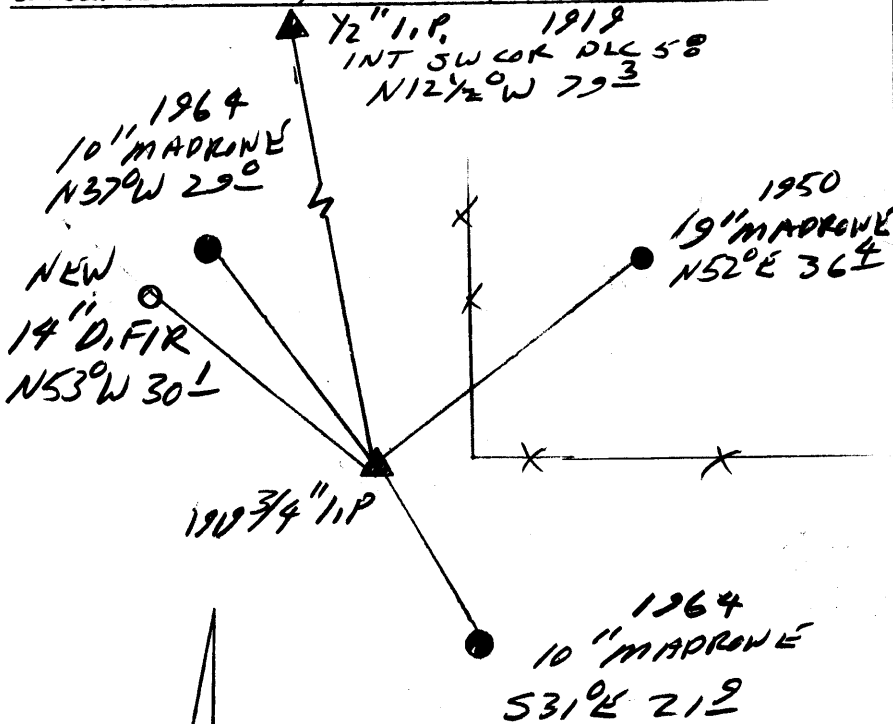

Location & Comments

CORNER LINES WEST  
12' FROM A EASTERN  
AND NORTHERLY RUNNING  
E BOUND LINES

Comp. Declin. 17 3/4° E  
Agency DCSD  
Party Chief RANDALL W. SMITH  
Notekeeper [Signature]  
Witnesses STEPHEN J. FLAISE

Address

Surveyor's Seal

REGISTERED  
PROFESSIONAL  
LAND SURVEYOR

[Signature]  
EXPIRES 6-30-98

OREGON  
JULY 25, 1990  
RANDALL W. SMITH  
2489