

GOVERNMENT CORNER RESTORATION FORM

Date: 7/14/97 By: BC

Township 25S Range 4W Sec. 19

County DOUGLAS This survey consists of:

State OR Date 7-8-97 No. _____

Map: _____

Narrative: _____

Corner Designation

Corner Rpt: CS 64/75-18

S24/S19
S25/S30

DOUGLAS COUNTY
SURVEYOR

Condition of Survey:

Not Found

Renewed

Unrecorded

Surveyed In

Referenced Out

Previous Renewals 1957 BLM, 1996 HOFFMAN

MONUMENT DETAIL

Monument(s) Found: (Condition and Source)

3/4" BRASS CAP ON A 2 1/2" OD. IRON PIPE, PROTRUDS 2" ABOVE GROUND, 1957

US CADASTRAL SURVEY

T25S
R5W | R4W
S24/S19
S25/S30

1957

BUREAU OF LAND MANAGEMENT

Accessories Found:

- 80" NOW 51" DIA 5 FT HIGH D. FIR STUMP, WITH A PREVIOUSLY OPENED BLAZE, SCRIBING VISIBLE "25S", BEARS S39°E 29.2 FT (AGREES WITH REC.) OBT
- 40" NOW 20" DIA 10 FT HIGH BROKEN D. FIR SNAG WITH HEALED BLAZE, BEARS S19°W, 17.8 FT (AGREES WITH REC.) OBT
- 15" NOW 18" DIA, D. FIR WITH A FULLY HEALED SINGLE BLAZE, BEARS N16 1/2°E, 135.6 FT. (AGREES WITH REC.) 1957
- 9" NOW 18" DIA. 2 FT HIGH ROTTING CEDAR STUMP WITH A FULLY HEALED BLAZE BEARS S75°E, 131.1 FT (REC S75°E, 132.7 FT) 1957
- 45" NOW 36" DIA 2 FT HIGH ROTTING D. FIR STUMP, WITH SCRIBING VISIBLE "T25S", BEARS N33 1/4°W, 37.0 FT (AGREES WITH REC.) 1957
- FOUND AN 11" DIA D. FIR WITH A FULLY HEALED DOUBLE BLAZE, BEARS N67 1/4°W, 25.6 FT (AGREES WITH 1992 BLM BT TAG)

RENEWAL

Monument Set (Procedure and Description)

Monument Detail

NONE


N/A

New Accessories

13" DIA. D. FIR SINGLE BLAZED AND SCRIBED
" T255 R4W S30 CS BT", BEARS S33°E, 8.3 FT

18" DIA. MAPLE DOUBLE BLAZED AND SCRIBED
" T255 R5W S24 CS BT", BEARS N43½°W 19.0 FT

Sketch of Monument, Accessories, and General Area

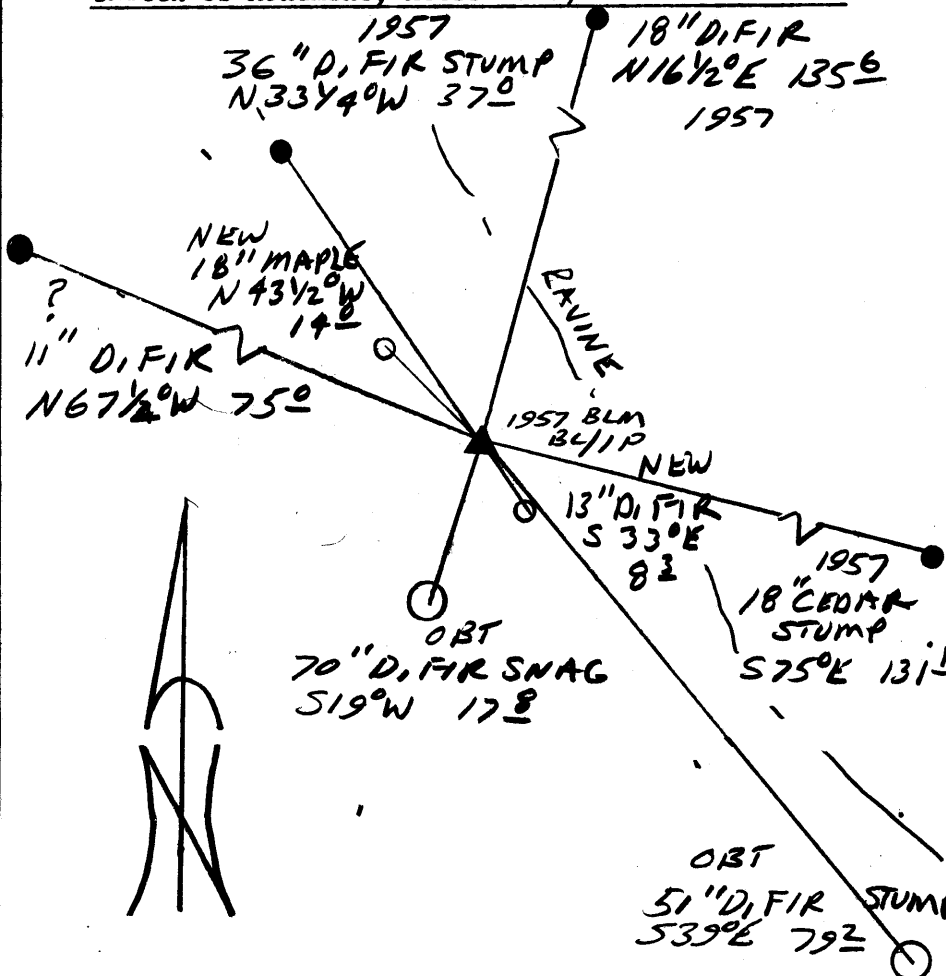

Location & Comments

Comp. Declin. 17 3/4° E
 Agency DESO
 Party Chief RANDALL W SMITH
 Notekeeper Randall W Smith
 Witnesses STEPHEN J FLAISE

Address

Surveyor's Seal

REGISTERED
 PROFESSIONAL
 LAND SURVEYOR

Randall W Smith
 17 APR 25 6-30-98

OREGON
 JULY 25, 1990
 RANDALL W. SMITH
 2469