

RENEWAL

Monument Set (Procedure and Description)

Monument Detail

NONE


N/A

New Accessories

7" DIA W. OAK DOUBLE BLAZED AND SCRIBED "Y4523CS13T"
 BEARS, N66Y20W, 5.4 FT.

7" DIA. D. FIR DOUBLE BLAZED AND SCRIBED "Y4526CSBT"
 BEARS S44E 29.8 FT

Sketch of Monument, Accessories, and General Area


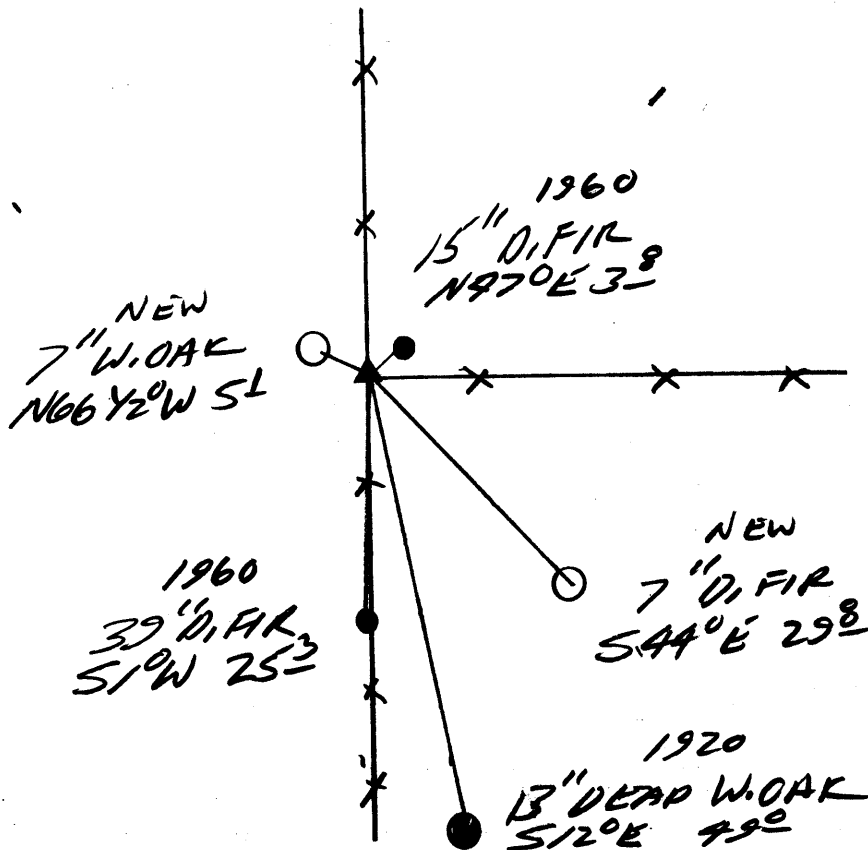


Location & Comments

CORNER LIES AT THE INTERSECTION OF A N-S-E FENCE LINES

Comp. Declin. 173/4°E
 Agency DCSG
 Party Chief ED MCUREAN
 Notekeeper RANDALL W SMITH
 Witnesses [Signature]

Address

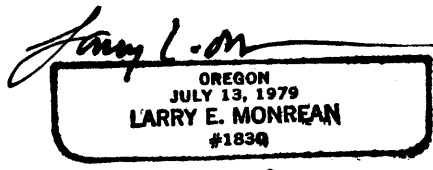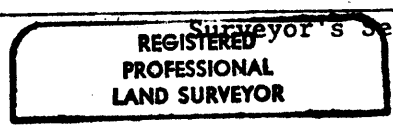

CERT. EXP. 12-31-98