

Monument Set (Procedure and Description)

Monument Detail

NONE


N/A

New Accessories

11" DIA CEDAR DOUBLE BLAZED AND SCRIBED
"Y4522 CS BT" BEARS N 88° E 7.5 FT

18" DIA. MADRONE BARK SCRIBED "Y4521 CS BT"
BEARS N 11° W, 8.5 FT

Sketch of Monument, Accessories, and General Area

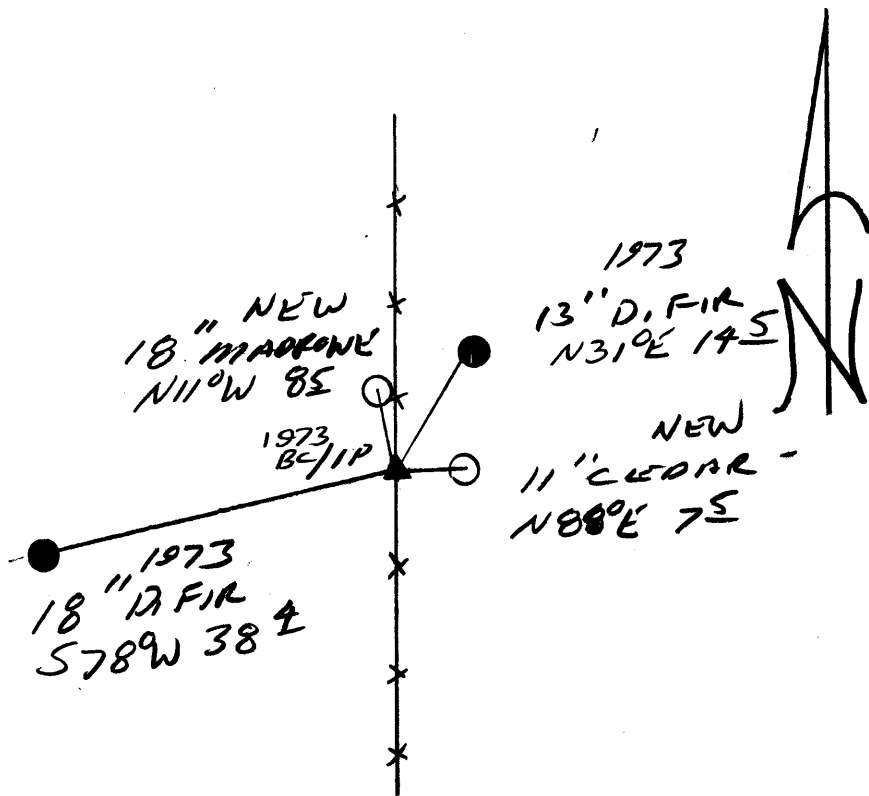

Location & Comments

Comp. Declin. 17 3/4° E
 Agency DCSO
 Party Chief ED MONREAN
 Notekeeper RANDALL W SMITH
 Witnesses [Signature]

Address

Surveyor's Seal

REGISTERED
 PROFESSIONAL
 LAND SURVEYOR

[Signature]
 CERT. EXP. 12/31/98

OREGON
 JULY 13, 1979
 LARRY E. MONREAN
 #1830