

GOVERNMENT CORNER RESTORATION FORM

Date: 7/25/97 By: BC

Township 26S Range 1W Sec. 30 County DOUGLAS

This survey consists of:

State OR Date 7-22-97 No.

Corner Ref: CS 64/75-30

Corner Designation

CC | S30
S31

DOUGLAS COUNTY

Condition: SURVEYED only

Not Found

Renewed

Unrecorded

Surveyed In

Referenced Out

MONUMENT DETAIL

Previous Renewals 1967 DCSO REN #15

Monument(s) Found: (Condition and Source)

2 1/2" DIA BRASS CAP ON
A 1 1/2" O.D. IRON PIPE,
PROTRUDES 12" ABOVE GROUND
(1967)

COUNTY SURVEYORS OFFICE
T 26S

NOTE: 1967 DCSO BC/1P
SET IN ERROR. 1967 DCSO
USED A 1916 RESURVEY BT
AND A BRG + DIST FROM
1910

R | S30 | R
2 CC | S31 | W
W

1967

NO CORNER STONE FOUND

Accessories Found:

BRG'S + DIST TAKEN FROM 1967 DCSO BC/1P
44" NOW 49" DIA D.F.R WITH A FULLY HEALED
SINGLE BLAZE, BEARS N 38° E, 29.4 FT (REC
N 40° E 32.0 FT) (1967)

14" NOW 13" DIA HEMLOCK WITH A PARTIALLY HEALED
SINGLE BLAZE SCRIBING VISIBLE "26S RW S31
CS BT" BEARS S 34° E, 39.7 FT (REC, S 32° E
39.7 FT) (1967)

12" NOW 17" DIA HEMLOCK WITH A PREVIOUSLY
OPENED UNHEALED BLAZE, SCRIBING VISIBLE "BT"
FACING N 70° W, BEARS S 30° E, 15.2 FT
(REC FROM 1967 S 27° E 15.2 FT) NOTE
THIS IS A BT MARKED IN 1916 MENSCH
RESURVEY)

NOT A BT
8" NOW 10" DIA HEMLOCK WITH A PREVIOUSLY
OPENED CHOPPED OUT BLAZE (BEARS S 99° 40' W
30.9 FT. 1910 BT SCRIBING AXED OUT IN 1916)

RENEWAL

Monument Detail

Monument Set (Procedure and Description)

BRASS CAP FROM 1967 RENEWAL
 IS SAWED OFF I.P. NOW
 PROTRUDES 8" ABOVE GROUND

AT A POINT DETERMINED FROM
 1916 RESURVEY BY 17" DIA.
 HEMLOCK (S 70° E 17.2 FT)
 A 2 1/2" DIA BRASS CAP ON A 1 1/2"
 O.D. BY 32" LONG IRON PIPE
 IS SET, BC/IP PROTRUDES 10"
 ABOVE GROUND. BC/IP IS
 SURROUNDED BY A MOUND OF
 STONE

DOUGLAS COUNTY SURVEYORS
 T265


R	530	R
2 CC,		
W	531	W

1997
 OFFICE

New Accessories

1967 1 1/2" O.D. IRON PIPE BEARS N 49 1/4° E, 10.7 FT
 1967 13" HEMLOCK BEARS S 51 1/2° E, 35.1 FT
 1967 49" D. FIR BEARS N 41° E, 39.9 FT

Sketch of Monument, Accessories, and General Area

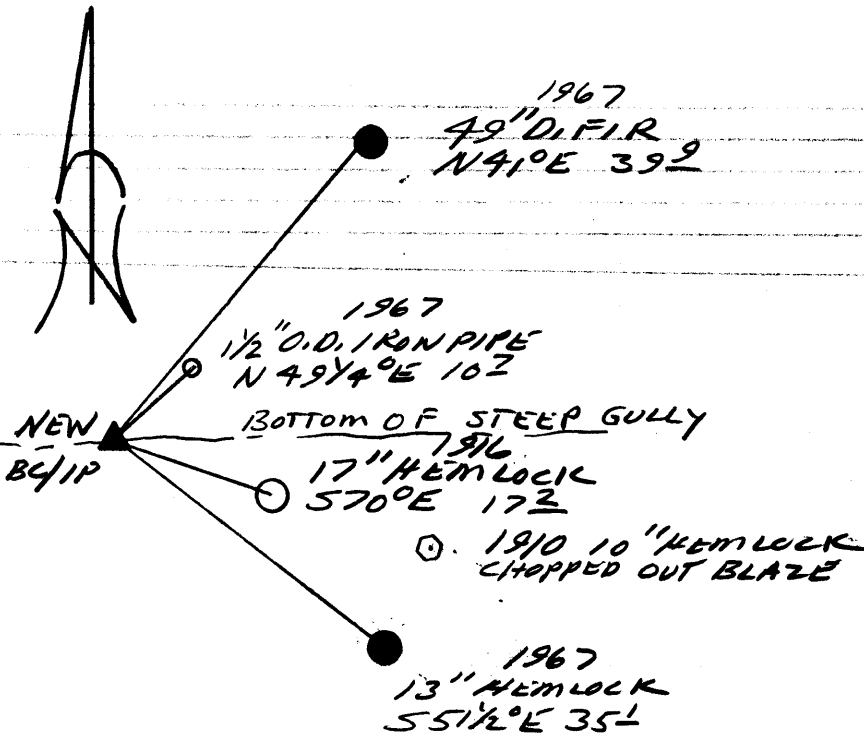

Location & Comments

CORNER IS AT THE
 BOTTOM OF A STEEP
 GULLY THAT CONVEYS
 WATER. CORNER IS
 IN A OLD GROWTH
 FOREST.

Comp. Declin. 17 3/4° E
 Agency DCSO
 Party Chief RANDALL W SMITH
 Notekeeper [Signature]
 Witnesses STEPHAN FLAUSCH

Address

Surveyor's Seal

REGISTERED
 PROFESSIONAL
 LAND SURVEYOR

Randall W Smith
 EXPIRES 6-30-98

OREGON
 JULY 25, 1990
 RANDALL W. SMITH
 2409