

GOVERNMENT CORNER RESTORATION FORM

Date: 9/3/97 By: PR
This survey consists of:

Township 253 Range 4W Sec. 19 County DOUGLAS
State OK Date 8-7-97 No. CS 64/75-31

Corner Designation

DOUGLAS COUNTY
SURVEYOR

- Condition Report Only
- Not Found
- Renewed
- Unrecorded
- Surveyed In
- Referenced Out

$\frac{1}{4}$ $\frac{S19}{S30}$

Previous Renewals 1957 + 1982 BLM, 1964 DCSO

Monument(s) Found: (Condition and Source)

3 1/4" DIA BRASS CAP ON AN IRON
PIPK IS FOUND 2" BELOW GROUND.
(1957)

U.S. CADASTRAL SURVEY
T25S R4W

$\frac{1}{4}$ $\frac{S19}{S30}$

1957
BUREAU OF LAND MANAGEMENT

Accessories Found:

14" NOW 24" DIA. 2 FT HIGH ROTTED D. FIR STUMP
WE OPEN AND FIND SCRIBING "BT" BEARS S42°E,
5.3 FT. (AGREES WITH LATEST REC.) OBT

REMAINS OF ROTTED D. FIR FOUND AT REC. POSITION OF
ORIG. NE BT "N41 1/2°E, 23.8 FT"

20" NOW 38" DIA. D. FIR WITH A PREVIOUSLY OPENED
UNHEALED BLAZE, NO SCRIBING VISIBLE, BEARS
S 21°W, 21.8 FT 1957

30" NOW 30" DIA. DOWN D. FIR WITH A FULLY HEALED
SINGLE BLAZE, ROOT HOLE AGREES WITH REC. "N 70W,
33.0 FT" 1957

29" NOW 18" DIA D. FIR WITH A FULLY HEALED DOUBLE
BLAZE, BEARS S 33°E, 28.0 FT (AGREES WITH REC.)
1964

10" NOW 12" DIA. D. FIR WITH A FULLY HEALED SINGLE
BLAZE, BEARS N 56 3/4°E, 23.1 FT (AGREES WITH REC.)
1982

RENEWAL

Monument Set (Procedure and Description)

NONE


Monument Detail

N/A

New Accessories

11" DIA. D. FIR DOUBLE BLAZED AND SCRIBED "Y4519 CS BT"
BEARS N 2 1/2° W, 17.3 FT

Sketch of Monument, Accessories, and General Area

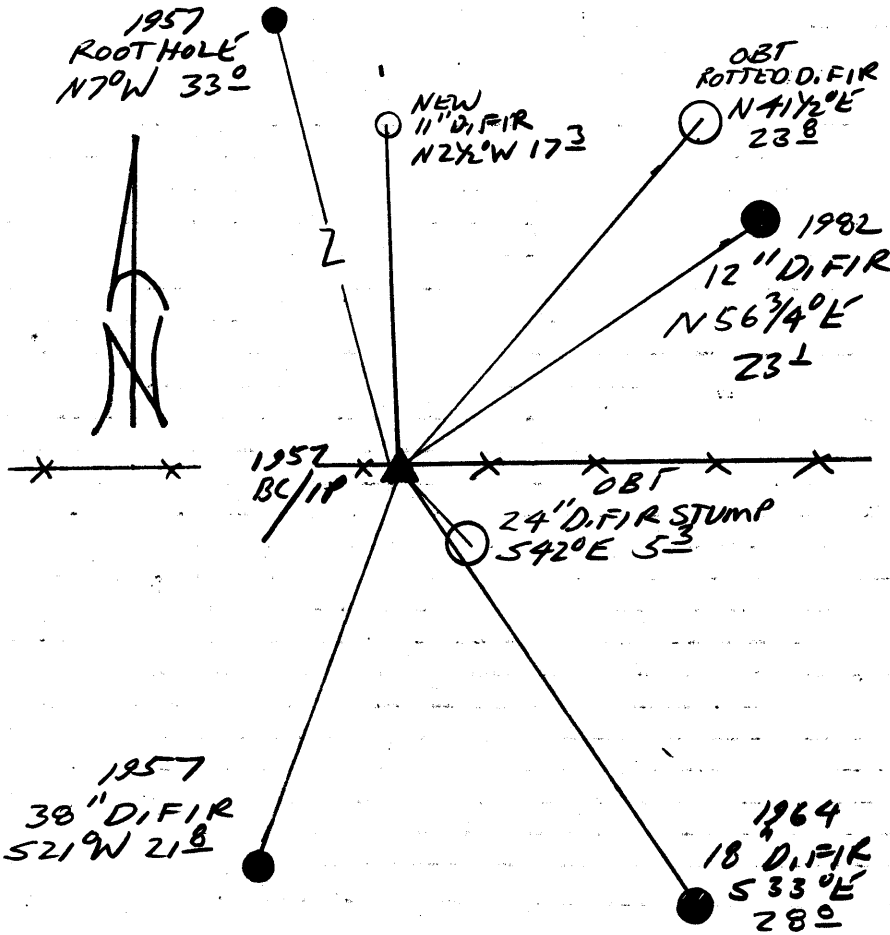

Location & Comments

CORNER LIPSINAN
E-W FENCE LINE

Comp. Declin. 17 3/4° E
 Agency DC SO
 Party Chief RANDALL W. SMITH
 Notekeeper [Signature]
 Witnesses STEPHEN J. FLAUSCH

Address

Surveyor's Seal

REGISTERED
 PROFESSIONAL
 LAND SURVEYOR

[Signature]
 5/11/98 6-30-98

OREGON
 JULY 25, 1990
 RANDALL W. SMITH
 2469