


GOVERNMENT CORNER RESTORATION FORM

Date: 9/16/97 By: BC

Township 25S Range SW Sec. 21 County DOUGLAS This survey consists of:

State OR Date 7-23-97 No. \_\_\_\_\_ Narrative \_\_\_\_\_

Corner Designation PERPETUATED A POINT DENOTED AS CORNER IN 1972 + 1973 RENEWALS Corner Plot: CS 104/75-32

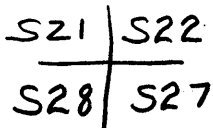

- DOUGLAS COUNTY SURVEYOR
- Condition Only
  - Not Found
  - Renewed
  - Unrecorded
  - Surveyed In
  - Referenced Out

PI # 400300

Previous Renewals 1923 COLE, 1955 FORD, 1972 ROGERS + 1973 DC56

Monument(s) Found: (Condition and Source)

NO CORNER MONUMENT FOUND

N/A

Accessories Found:

14" NOW 24" DIA 4 FT HIGH ROTTED OAK SNAG SHOWS EVIDENCE OF OLD SEARCH FOR SCRIBING, NONE VISIBLE OR FOUND, BEARS S66°E, 15.4 FT (AGREES WITH REC.) 1923?

(4) 5/8" I.R. FROM 1973 DC56 RENEWAL AREA FOUND

<u>N37°W</u>	<u>5.14</u>
<u>N46°E</u>	<u>7.75</u>
<u>S11°W</u>	<u>5.80</u>
<u>S69°E</u>	<u>7.23</u>

(ALL AGREE WITH REC.)

RENEWAL

Monument Set (Procedure and Description)

Monument Detail

AT A POSITION DETERMINED  
 FROM 1973 DCSO 5/8" I.R.'S  
 AND SNAG, A 2 7/8" BRASS  
 CAP ON A 1 3/8" O.D. IRON PIPE  
 IS SET, PROTRUDES 6" ABOVE  
 GROUND.

DOUGLAS COUNTY SURVEYORS  
 T253

R 521 | 522  
 S 528 | 527  
 W


1997  
 OFFICE

232

New Accessories

17" D. FIR DOUBLE BLAZED AND SCRIBED "T253 R5WS 21 CS BT"  
 BEARS N 27 1/2° W, 10.6 FT  
 5" D. FIR DOUBLE BLAZED AND SCRIBED "X BT"  
 BEARS N 78° E 23.8 FT  
 18" MADRONE DOUBLE BLAZED AND SCRIBED "T253 R5WS 27 CS BT"  
 BEARS S 62 1/2° W 31.8 FT

Sketch of Monument, Accessories, and General Area

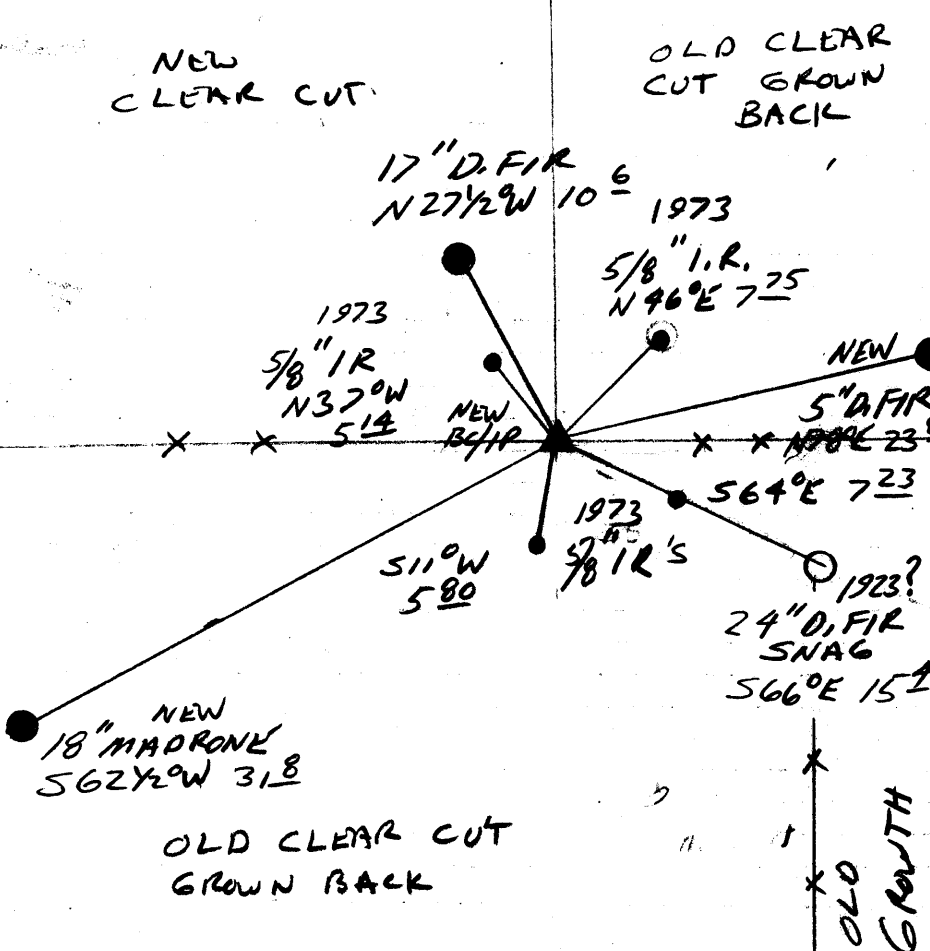

Location & Comments

CORNER LIES NEAR  
 THE INTERSECTION OF  
 A E-W-S RUNNING  
 DOWN FRENCH LINE (OLD)

OLD CLEAR CUTS - NE + SW  
 NEW CLEAR CUT - NW  
 OLD GROWTH - SE

Comp. Declin. 17 3/4° E  
 Agency DCSO  
 Party Chief RANDALL W. SMITH  
 Notekeeper [Signature]  
 Witnesses STEPHEN J. FLAVSK

Address

REGISTERED Surveyor's Seal  
 PROFESSIONAL  
 LAND SURVEYOR

[Signature]  
 EX-105-98

OREGON  
 JULY 25, 1989  
 RANDALL W. SMITH  
 200