

GOVERNMENT CORNER RESTORATION FORM

Date: 9.16.97 By: PC

Township 25S Range 4W Sec. 18 County DOUGLAS

This survey consists of:

State OR Date 8-6-97 No. \_\_\_\_\_

Narrative: \_\_\_\_\_  
Corner Rpt: CS 64/75-34

Corner Designation

13	18
24 | 19

DOUGLAS COUNTY  
SURVEYOR

- Condition Report Only
- Not Found
- Renewed
- Unrecorded
- Surveyed In
- Referenced Out

Previous Renewals 1957 BLM, 1971 MCLIND (M 43-79) MONUMENT DETAIL

Monument(s) Found: (Condition and Source)

5/8" I.R. BENT FLUSH WITH GROUND. (1971)

FOUND 3" DIA. BLM BRASS CAP IRON PIPE 23" BELOW GROUND. 1957

(NOTE: BLM BELLIP NOT FOUND BY 1971 RENEWAL)

T 25 S  
R 5W R 4W  
S 13	S 18
S 24 | S 19  
1957

ORIENTATED SE 27

Accessories Found:

10" NOW 19" DIA ASH WITH A FULLY HEALED SINGLE BLAZE BEARS N 67 1/2° W, 206.6 FT (AGREES WITH REC.) 1957 BLM

7" NOW 9" DIA ASH WITH A FULLY HEALED SINGLE BLAZE BEARS S 22° W, 345.2 FT (AGREES WITH REC.) 1957 BLM

11" NOW 18" DIA ASH WITH A FULLY HEALED SINGLE BLAZE BEARS S 37° E 390.1 FT (AGREES WITH REC.) 1957 BLM

12" NOW 20" DIA ASH WITH A PARTIALLY HEALED SINGLE BLAZE, SCRIBING VISIBLE "5S 4W" BEARS N 67 1/2° E 281.8 FT (AGREES WITH REC.) 1957 BLM

✓ 705407

RENEWAL

Monument Detail

Monument Set (Procedure and Description)

PLUMB POSITION OF 5/8" I.R.  
 IS REFERENCED. I.R. MEASURED  
 29" LONG IS STRAIGHTENED  
 AND RESET AT REFERENCED  
 POSITION 10" BELOW GROUND.


I.R. BEARS WEST 0.6 FT  
 FROM BLM BC/1P.

N/A

New Accessories

N/A

Sketch of Monument, Accessories, and General Area

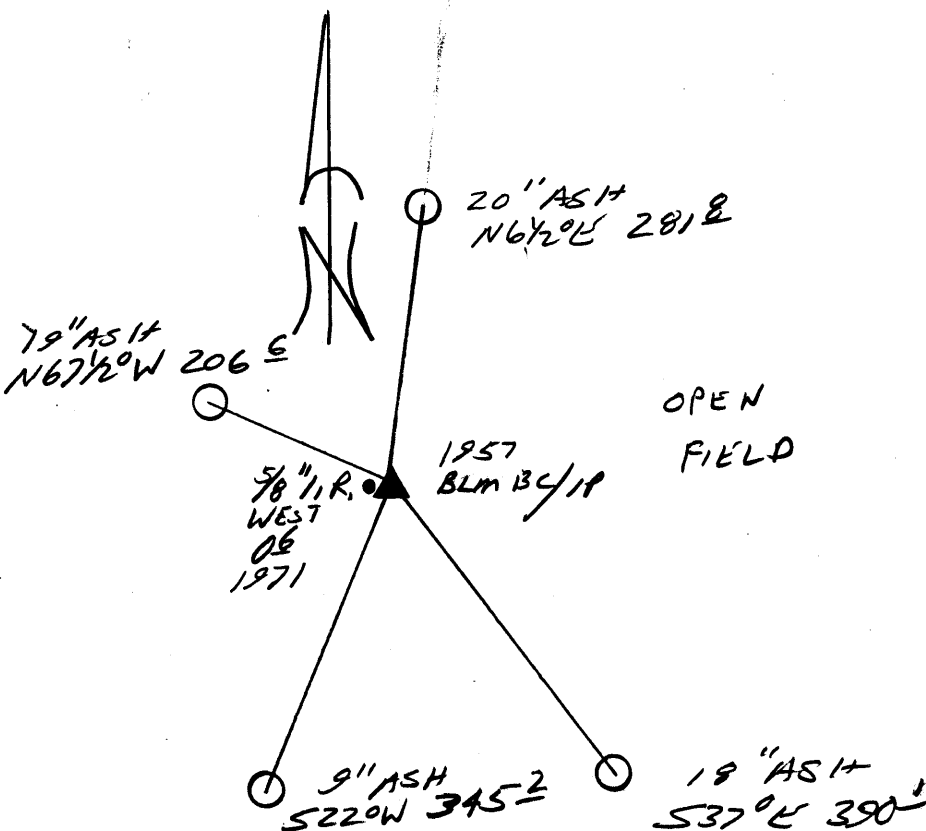

Location & Comments

Comp. Declin. 17 3/4° E  
 Agency DCSG  
 Party Chief RANDALL W SMITH  
 Notekeeper [Signature]  
 Witnesses STEPHEN J FLAUSC

Address

Surveyor's Seal

REGISTERED  
 PROFESSIONAL  
 LAND SURVEYOR

Randall W Smith  
 EXPIRES 6-30-99

OREGON  
 JULY 25, 1990  
 RANDALL W. SMITH  
 2489